

Washington
G 2073

MISSISSIPPI DEPARTMENT OF NATURAL RESOURCES
Bureau of Land and Water Resources
Southport Mall
P.O. Box 10631
Jackson, Mississippi 39209
WATER WELL DRILLERS LOG

2-28 1988 date well completed
Scholtz Drilling Washington firm name
county well located


LANDOWNER: Charles Merrill
South Main
Greenville, MS
(mailing address)

description of formations encountered	from	to
	CLAY	0
FINE SAND	40	80
SHALE	80	340
SAND	340	420

WELL LOCATION:
sec. 12 T 11 N R 8 E S 1 W
1 miles S of Greenville
(distance) (direction) (nearest town)

WELL PURPOSE: HOME
(home, irrigation, municipal, industrial)

- WELL COMPLETION DATA:
- (1) diameter (inches) 2'
 - (2) total depth (feet) 420
 - (3) static water level (feet) 38' below above top of ground.
 - (4) casing PVC 410' (material) (depth)
 - _____ if telescope see back. (size)
 - (5) screen 10' 410' (length) (depth to top)
 - 2" PVC (size) (material)
 - (6) pump 1 10 (HP) (yield gpm)
 - ele (type power)
 - (7) electric log X (yes or no)
 - X (organization running log)
 - (8) how well bottom plugged b/w

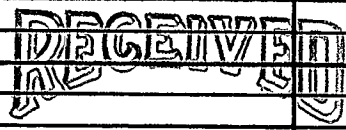


MAR 11 1988

Department of Natural Resources
Bureau of Land & Water Resources

DRILLERS REMARKS:

If well telescopes please sketch and show depths.

GROUND LEVEL

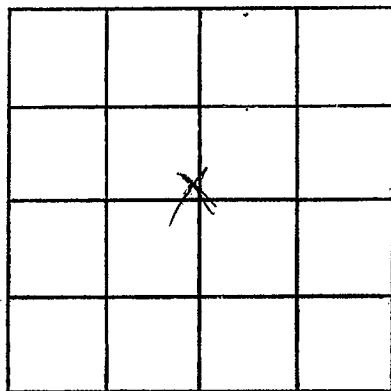

SECTION 12

Please indicate well location X.

ADDITIONAL INFORMATION

If more than one screen,
show locations of each on sketch.