

**MISSISSIPPI DEPARTMENT OF NATURAL RESOURCES**  
Bureau of Land and Water Resources

P.O. Box 10631  
Jackson, Mississippi 39209  
**WATER WELL DRILLERS LOG**

COUNTY WELL LOCATED <i>Washington</i>	
WELL NUMBER <i>G</i>	CODED
DATE WELL COMPLETED <i>9-24-90</i>	

PERMIT NUMBER
NAME OF DRILLING FIRM <i>Schultz Drilling</i>

NAME & MAILING ADDRESS OF LANDOWNER <i>Lake Lee Hunting Club</i> <i>Greenville Ms 38101</i>			
WELL LOCATION:	SEC <i>1</i>	TOWNSHIP <i>17</i>	RANGE <i>8</i>
DISTANCE <i>5</i> Miles	DIRECTION <i>S</i>	NEAREST TOWN <i>Greenville</i>	
OTHER LANDMARK			
WELL PURPOSE: <input checked="" type="checkbox"/> Home Irrigation, <input type="checkbox"/> Municipal, <input type="checkbox"/> Industrial, <input type="checkbox"/> Fish Pond, etc.			

PUMP DATA		
PUMP TYPE (Circle One): <input checked="" type="checkbox"/> Submersible, <input type="checkbox"/> Turbine, <input type="checkbox"/> Jet, <input type="checkbox"/> Flowing Well, Other (Describe) _____		
POWER TYPE (Circle One): <input checked="" type="checkbox"/> Electric, <input type="checkbox"/> Tractor, <input type="checkbox"/> Diesel, <input type="checkbox"/> Gasoline, <input type="checkbox"/> Butane, Other (Describe) _____		
Pump Capacity (GPM) <i>20</i>	No. of Stages <i>7</i>	Setting Depth <i>105</i> FT.
PUMP TEST		
Well yielded _____ GPM with a drawdown of _____ ft. after _____ hours of pumping		

WELL DATA		
Well Depth <i>420</i>	Casing Diameter (In.) <i>4 x 2</i>	Casing Length (Ft.) <i>390</i>
Type of Casing <i>pvc</i>	Hole Depth <i>420</i>	Depth to Static Water Level <i>26</i>
TYPE OF COMPLETION: (Circle One or More): <input checked="" type="checkbox"/> Gravel Packed, <input type="checkbox"/> Underreamed, <input type="checkbox"/> Telescoped, <input checked="" type="checkbox"/> Natural Development, <input type="checkbox"/> Open Hole, <input type="checkbox"/> Other (Describe) _____		
Top of Lap Pipe or Reduction in Casing  FEET IF TELESKOPED OR MORE THAN ONE SCREEN: USE BACK PAGE		

LOG DATA	
TYPE OF LOG RUN (Circle One): <input checked="" type="checkbox"/> No Log Run, <input type="checkbox"/> Electric, <input type="checkbox"/> Gamma Ray, <input type="checkbox"/> Density, <input type="checkbox"/> Sonic, <input type="checkbox"/> Neutron, Other (Describe) _____	
Name of Organization Running Log	

SCREEN DATA		
Diameter - Inches <i>2</i>	Length - Feet <i>30</i>	Slot Size - Inches <i>.008</i>
Screen Type <i>pvc</i>	Depth to Bottom - Feet <i>420</i>	

GEOLOGIC DATA (Office Use Only)			
Surface Elev.	Geologic Unit	Unit Thickness	Depth to Top
Subs. SWL	Date	Analysis	Aquifer Test
Driller's Remarks			


DESCRIPTION OF FORMATIONS ENCOUNTERED	FROM	TO
<i>clay</i>	<i>0</i>	<i>38</i>
<i>sand + p-gravel</i>	<i>38</i>	<i>118</i>
<i>clay</i>	<i>118</i>	<i>280</i>
<i>fine sand</i>	<i>280</i>	<i>320</i>
<i>med sand</i>	<i>320</i>	<i>340</i>
<i>Good sand</i>	<i>340</i>	<i>420</i>

FORMATIONS (Continued)	FROM	TO
<b>DISCOVERED</b>		
<b>OCT 24 1990</b>		
Department of Natural Resources Bureau of Land & Water Resources		
IF MORE SPACE IS NEEDED, USE BACK		

If well telescopes please sketch and show depths.

4 X 2

GROUND LEVEL

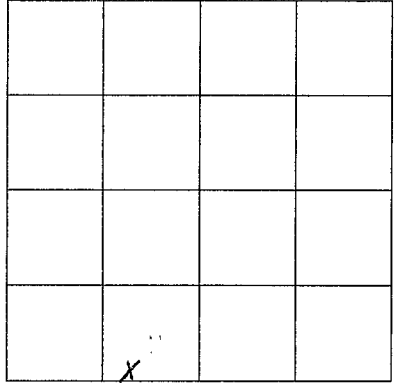

SECTION   1  

Please indicate well location X.

ADDITIONAL INFORMATION

---

---

If more than one screen, show location of each on sketch.