

MISSISSIPPI DEPARTMENT OF ENVIRONMENTAL QUALITY
Bureau of Land and Water Resources

P. O. Box 10631
Jackson, MS 39289-0631
WATER WELL DRILLERS LOG

COUNTY WELL LOCATED Washington	
WELL NUMBER G	CODED
DATE WELL COMPLETED 7-19-91	

1459

PERMIT NUMBER L
NAME OF DRILLING FIRM Schultz Drilling

NAME & MAILING ADDRESS OF LANDOWNER Robert May		
484 Idlewild Drive		
Greenville MS 38701		
WELL LOCATION: SEC	TOWNSHIP	RANGE
21	17	9
DISTANCE	DIRECTION	NEAREST TOWN
7 Miles	SW	of Greenville
OTHER LANDMARK 2 1/2 mile Greenville Ark Bridge		
WELL PURPOSE: Home, Irrigation, Municipal, Industrial, Fish Pond, etc.		

PUMP DATA		
PUMP TYPE (Circle One): Submersible, Turbine , Jet, Flowing Well, Other (Describe) _____		
POWER TYPE (Circle One): Electric, Tractor, Diesel , Gasoline, Butane, Other (Describe) _____ H/P _____		
Pump Capacity (GPM)	No. of Stages	Setting Depth
2000	2	60 FT.
PUMP TEST		
Well yielded _____ GPM with a drawdown of _____ ft. after _____ hours of pumping		

WELL DATA		
Well Depth 96	Casing Diameter (In.) 16	Casing Length (Ft.) 56
Type of Casing steel	Hole Depth 96	Depth to Static Water Level 14
TYPE OF COMPLETION: (Circle One or More): Gravel Packed , Underreamed, Telescoped, Natural Development, Open Hole, Other (Describe) hole plug		
Top of Lap Pipe or Reduction in Casing		
FEET	IF TELESCOPED OR MORE THAN ONE SCREEN: USE BACK PAGE	

LOG DATA	
TYPE OF LOG RUN (Circle One): Electric, Gamma Ray, Density, Sonic, Neutron, Other (Describe) _____ No Log Run	
Name of Organization Running Log	

SCREEN DATA		
Diameter - Inches 16	Length - Feet 40	Slot Size - Inches .050
Screen Type steel	Depth to Bottom - Feet 96	


GEOLOGIC DATA (Office Use Only)			
Surface Elev.	Geologic Unit	Unit Thickness	Depth to Top
Subs. SWL	Date	Analysis	Aquifer Test
Driller's Remarks			

DESCRIPTION OF FORMATIONS ENCOUNTERED	FROM	TO	FORMATIONS (Continued)	FROM	TO
Top soil	0	10	RECEIVED DEC 06 1991		
fine sand	10	35			
med sand	35	60			
course sand p-g	60	90			
gravel	90	96			
1					

IF MORE SPACE IS NEEDED, USE BACK

If well telescopes please sketch and show depths.

GROUND LEVEL

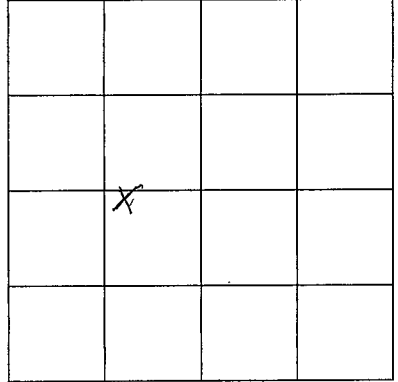


SECTION 21

Please indicate well location X.

ADDITIONAL INFORMATION

Multiple horizontal lines for entering additional information.

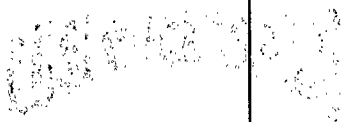

If more than one screen, show location of each on sketch.