

MISSISSIPPI DEPARTMENT OF ENVIRONMENTAL QUALITY
Bureau of Land and Water Resources

P. O. Box 10631
Jackson, MS 39289-0631
WATER WELL DRILLERS LOG

COUNTY WELL LOCATED Washington	
WELL NUMBER CT	CODED
DATE WELL COMPLETED 5-12-92	

PERMIT NUMBER
NAME OF DRILLING FIRM Schudco

NAME & MAILING ADDRESS OF LANDOWNER D.S. Red Frazier		
Deerfield Rd		
Greenville MS 38901		
WELL LOCATION: SEC	TOWNSHIP	RANGE
24	17	8
DISTANCE	DIRECTION	NEAREST TOWN
5 Miles	South	Greenville
OTHER LANDMARK		
WELL PURPOSE <input checked="" type="checkbox"/> Home Irrigation, Municipal, Industrial, Fish Pond, etc.		

PUMP DATA		
PUMP TYPE (Circle One): <input checked="" type="checkbox"/> Submersible Turbine, Jet Flowing Well, Other (Describe) _____		
POWER TYPE (Circle One): Electric, Tractor, Diesel, Gasoline, Butane, Other (Describe) _____ H/P 1		
Pump Capacity (GPM)	No. of Stages	Setting Depth
20	8	105 FT.
PUMP TEST		
Well yielded _____ GPM with a drawdown of _____ ft. after _____ hours of pumping		

WELL DATA		
Well Depth 480	Casing Diameter (In.) 4X2	Casing Length (Ft.) 460
Type of Casing pvc	Hole Depth 480	Depth to Static Water Level 32
TYPE OF COMPLETION: (Circle One or More): Gravel Packed, Underreamed, Telescoped, <input checked="" type="checkbox"/> Natural Development, Open Hole, Other (Describe) Hole plug + cement		
Top of Lap Pipe or Reduction in Casing		
FEET	IF TELESCOPED OR MORE THAN ONE SCREEN: USE BACK PAGE	

LOG DATA	
TYPE OF LOG RUN (Circle One): Electric, Gamma Ray, Density, Sonic, Neutron, Other (Describe) _____	
<input checked="" type="checkbox"/> No Log Run	
Name of Organization Running Log	



SCREEN DATA		
Diameter - Inches 2	Length - Feet 20	Slot Size - Inches .010
Screen Type pvc	Depth to Bottom - Feet 480	

GEOLOGIC DATA (Office Use Only)			
Surface Elev.	Geologic Unit	Unit Thickness	Depth to Top
Subs. SWL	Date	Analysis	Aquifer Test
Driller's Remarks			

DESCRIPTION OF FORMATIONS ENCOUNTERED	FROM	TO	FORMATIONS (Continued)	FROM	TO
Top soil + clay	0	25	DECEMBER		
sand + p-g	25	82			
clay + sandy shell	82	400			
fine sand	400	440			
med. sand	440	460			
good coarse sand	460	480			
			AUG 11 1992		
			Dept. of Environmental Quality Bureau of Land & Water Resources		
			IF MORE SPACE IS NEEDED, USE BACK		

If well telescopes please sketch and show depths.

GROUND LEVEL

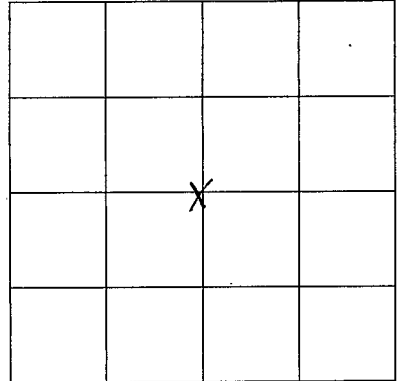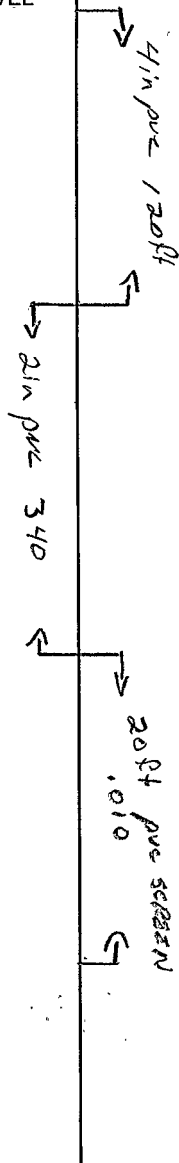

SECTION 24

Please indicate well location X.

ADDITIONAL INFORMATION

If more than one screen, show location of each on sketch.