

MISSISSIPPI DEPARTMENT OF ENVIRONMENTAL QUALITY

Office of Land and Water Resources

P. O. Box 10631
Jackson, MS 39289-0631
WATER WELL DRILLERS LOG

COUNTY WELL LOCATED <u>Washington</u>	
WELL NUMBER <u>GJ</u>	CODED
<u>2 1/2" dia</u>	
DATE WELL COMPLETED <u>4-11-94</u>	

PERMIT NUMBER <u>GW 36307</u>
NAME OF DRILLING FIRM <u>Schubert, Ltd.</u>

NAME & MAILING ADDRESS OF LANDOWNER <u>Wm. Delaney Law Firm</u> <u>TUNICA, MS</u> <u>Auth Sawyer</u> <u>Memphis TN 38111</u>		
WELL LOCATION: SEC	TOWNSHIP	RANGE
<u>31</u>	<u>17</u>	<u>N 8 E</u>
DISTANCE	DIRECTION	NEAREST TOWN
<u>3</u> Miles	<u>NE</u> of	<u>Wayside</u>
OTHER LANDMARK		
WELL PURPOSE: Home, <u>Irrigation</u> , Municipal, Industrial, Fish Pond, etc.		

PUMP DATA		
PUMP TYPE (Circle One): <u>Submersible</u> , Turbine, Jet, Flowing Well, Other (Describe) _____		
POWER TYPE (Circle One): <u>Electric</u> , Tractor, Diesel, Gasoline, Butane, Other (Describe) _____ H/P <u>20</u>		
Pump Capacity (GPM) <u>800</u>	No. of Stages <u>1</u>	Setting Depth <u>60</u> FT.
PUMP TEST		
Well yielded _____ GPM with a drawdown of _____ ft. after _____ hours of pumping		

WELL DATA		
Well Depth <u>80</u>	Casing Diameter (In.) <u>10</u>	Casing Length (Ft.) <u>60</u>
Type of Casing <u>PVC</u>	Hole Depth <u>81</u>	Depth to Static Water Level <u>24</u>
TYPE OF COMPLETION: (Circle One or More): <u>Gravel Packed</u> , Underreamed, Telescoped, Natural Development, Open Hole, Other (Describe) _____		

LOG DATA	
TYPE OF LOG RUN (Circle One): Electric, Gamma Ray, Density, Sonic, <u>No Log Run</u> , Neutron, Other (Describe) _____	
Name of Organization Running Log	

WELL GROUTED TO A DEPTH OF <u>10</u> FEET Type Grout (circle one): Cement, <u>Bentonite</u> , or Mix

GEOLOGIC DATA (Office Use Only)			
Surface Elev.	Geologic Unit	Unit Thickness	Depth to Top
Subs. SWL	Date	Analysis	Aquifer Test

SCREEN DATA		
Diameter - Inches <u>10</u>	Length - Feet <u>20</u>	Slot Size - Inches <u>.033</u>
Screen Type <u>PVC</u>	Depth to Bottom - Feet <u>80</u>	


Driller's Remarks

DESCRIPTION OF FORMATIONS ENCOUNTERED	FROM	TO	FORMATIONS (Continued)	FROM	TO
<u>Clay</u>	<u>0</u>	<u>45</u>	RECEIVED AUG 16 1994 Dept. of Environmental Quality Office of Land & Water Resources		
<u>course sand gravel</u>	<u>45</u>	<u>80</u>			
<u>clay</u>	<u>80</u>	<u>81</u>			

IF MORE SPACE IS NEEDED, USE BACK

If well telescopes please
sketch and show depths.

GROUND LEVEL

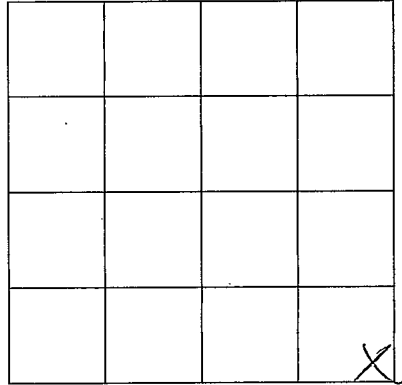

SECTION 31

Please indicate well location X.

ADDITIONAL INFORMATION

If more than one screen,
show location of each on sketch.