

**MISSISSIPPI DEPARTMENT OF ENVIRONMENTAL QUALITY**

Office of Land and Water Resources

P. O. Box 10631  
Jackson, MS 39289-0631  
**WATER WELL DRILLERS LOG**

COUNTY WELL LOCATED <b>Washington</b>	
WELL NUMBER <b>G</b>	CODED
DATE WELL COMPLETED <b>2/30 4-2-94</b>	

PERMIT NUMBER
NAME OF DRILLING FIRM <b>Schudco Ltd</b>

NAME & MAILING ADDRESS OF LANDOWNER <b>Mrs Thelma Potter</b> <b>Wayside MS</b> <b>38780</b>			
WELL LOCATION: SEC	TOWNSHIP	RANGE	
<b>36</b>	<b>17</b>	<b>8</b>	<b>W</b>
DISTANCE	DIRECTION	NEAREST TOWN	
<b>2</b> Miles	<b>E</b>	of <b>Wayside</b>	
OTHER LANDMARK			
WELL PURPOSE: Home <u>Irrigation</u> Municipal, Industrial, Fish Pond, etc.			

PUMP DATA		
PUMP TYPE (Circle One): <u>Submersible</u> Turbine, Jet Flowing Well, Other (Describe) _____		
POWER TYPE (Circle One): <u>Electric</u> Tractor, Diesel, Gasoline, Butane, Other (Describe) _____ H/P _____		
Pump Capacity (GPM)	No. of Stages	Setting Depth  FT.
PUMP TEST		
Well yielded _____ GPM with a drawdown of _____ ft. after _____ hours of pumping		

WELL DATA		
Well Depth <b>85</b>	Casing Diameter (In.) <b>10 1/2</b>	Casing Length (Ft.) <b>65</b>
Type of Casing <b>pvc</b>	Hole Depth <b>85</b>	Depth to Static Water Level <b>21</b>
TYPE OF COMPLETION: (Circle One or More): <u>Gravel Packed</u> Underreamed, Telescoped, Natural Development, Open Hole, Other (Describe) _____		

LOG DATA	
TYPE OF LOG RUN (Circle One): * <u>No Log Run</u> , Electric, Gamma Ray, Density, Sonic, Neutron, Other (Describe) _____	
Name of Organization Running Log	

WELL GROUTED TO A DEPTH OF <b>10</b> FEET Type Grout (circle one): Cement, <u>Bentonite</u> , or Mix
---

GEOLOGIC DATA (Office Use Only)			
Surface Elev.	Geologic Unit	Unit Thickness	Depth to Top
Subs. SWL	Date	Analysis	Aquifer Test

SCREEN DATA		
Diameter - Inches <b>10</b>	Length - Feet <b>20</b>	Slot Size - Inches <b>1.032</b>
Screen Type <b>pvc</b>	Depth to Bottom - Feet <b>85</b>	


Driller's Remarks

DESCRIPTION OF FORMATIONS ENCOUNTERED	FROM	TO
<b>clay</b>	<b>0</b>	<b>50</b>
<b>sand + gravel</b>	<b>50</b>	<b>85</b>
<b>clay</b>	<b>85</b>	

FORMATIONS (Continued)	FROM	TO
<b>RECEIVED</b>		
<b>AUG 16 1994</b>		
Dept. of Environmental Quality Office of Land & Water Resources		
IF MORE SPACE IS NEEDED, USE BACK		

If well telescopes please sketch and show depths.

GROUND LEVEL

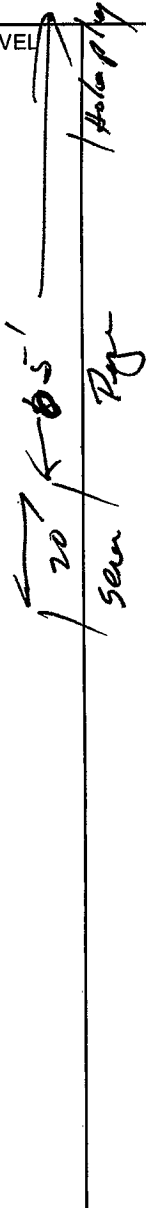

			X

SECTION 36

Please indicate well location X.

ADDITIONAL INFORMATION

If more than one screen,  
show location of each on sketch.