

MISSISSIPPI DEPARTMENT OF ENVIRONMENTAL QUALITY

Office of Land and Water Resources

P. O. Box 10631
Jackson, MS 39289-0631
WATER WELL DRILLERS LOG

COUNTY WELL LOCATED Washington	
WELL NUMBER 5	CODED
DATE WELL COMPLETED Aug 10-94	

PERMIT NUMBER
NAME OF DRILLING FIRM Schudco Ltd

NAME & MAILING ADDRESS OF LANDOWNER BASF		
103 BASF Rd.		
Sunwick 970 38701		
WELL LOCATION: SEC	TOWNSHIP	RANGE
5	17	9
	(N)	(E)
	(S)	(W)
DISTANCE	DIRECTION	NEAREST TOWN
5 Miles	SW of	Greenville
OTHER LANDMARK		
WELL PURPOSE: Home, Irrigation, Municipal, Industrial, Fish Pond, etc. Green House		

PUMP DATA		
PUMP TYPE (Circle One): Submersible Turbine, Jet, Flowing Well, Other (Describe) _____		
POWER TYPE (Circle One): Electric Tractor, Diesel, Gasoline, Butane, Other (Describe) _____ H/P _____		
Pump Capacity (GPM)	No. of Stages	Setting Depth
		FT.
PUMP TEST		
Well yielded _____ GPM with a drawdown of _____ ft. after _____ hours of pumping		

WELL DATA		
Well Depth 460	Casing Diameter (In.) 4	Casing Length (Ft.) 410
Type of Casing pvc	Hole Depth 460	Depth to Static Water Level 26
TYPE OF COMPLETION: (Circle One or More): Gravel Packed Underreamed, Telescoped, Natural Development, Open Hole, Other (Describe) _____		

LOG DATA	
TYPE OF LOG RUN (Circle One): Electric, Gamma Ray, Density, Sonic, No Log Run , Neutron, Other (Describe) _____	
Name of Organization Running Log	

WELL GROUTED TO A DEPTH OF 10 FEET Type Grout (circle one): Cement Bentonite, or Mix

GEOLOGIC DATA (Office Use Only)			
Surface Elev.	Geologic Unit	Unit Thickness	Depth to Top
Subs. SWL	Date	Analysis	Aquifer Test

SCREEN DATA		
Diameter - Inches 4	Length - Feet 50	Slot Size - Inches .006
Screen Type pvc	Depth to Bottom - Feet 460	


Driller's Remarks

DESCRIPTION OF FORMATIONS ENCOUNTERED	FROM	TO	FORMATIONS (Continued)	FROM	TO
Top soil	0	10	RECEIVED JAN 11 1995 Dept. of Environmental Quality Office of Land & Water Resources		
sand + gravel	10	110			
clay	110	350			
sand	350	460			

IF MORE SPACE IS NEEDED, USE BACK

If well telescopes please sketch and show depths.

GROUND LEVEL

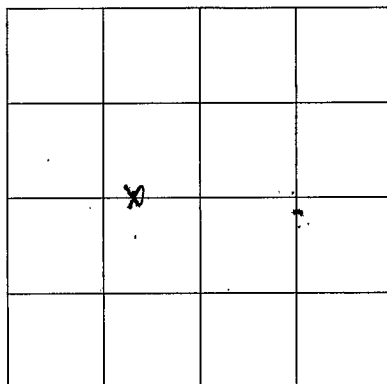

SECTION 5

Please indicate well location X.

ADDITIONAL INFORMATION

If more than one screen, show location of each on sketch.