

MISSISSIPPI DEPARTMENT OF ENVIRONMENTAL QUALITY

Office of Land and Water Resources

P. O. Box 10631
Jackson, MS 39289-0631
WATER WELL DRILLERS LOG

COUNTY WELL LOCATED <u>Washington</u>	
WELL NUMBER <u>G</u>	CODED
DATE WELL COMPLETED <u>2/28/95</u> <u>11-28-95</u>	

PERMIT NUMBER
NAME OF DRILLING FIRM <u>Schudco, Ltd.</u>

NAME & MAILING ADDRESS OF LANDOWNER <u>Aqua-Agri, LLC</u> <u>1274 Wilmot Rd.</u> <u>Greenville MS 38701</u>			
WELL LOCATION:	SEC	TOWNSHIP	RANGE
	<u>27</u>	<u>17</u>	<u>8</u>
DISTANCE	DIRECTION	NEAREST TOWN	
<u>2 1/2</u> Miles	<u>NE</u>	of <u>Wayssie</u>	
OTHER LANDMARK			
WELL PURPOSE: Home, Irrigation, Municipal, Industrial, <u>Fish Pond</u> , etc.			

PUMP DATA			
PUMP TYPE (Circle One): <u>Submersible</u> Turbine, Jet, Flowing Well, Other (Describe) _____			
POWER TYPE (Circle One): <u>Electric</u> , Tractor, Diesel, Gasoline, Butane, Other (Describe) _____ H/P <u>15</u>			
Pump Capacity (GPM)	No. of Stages	Setting Depth	
<u>750</u>	<u>1</u>	<u>60</u> FT.	
PUMP TEST			
Well yielded _____ GPM with a drawdown of _____ ft. after _____ hours of pumping			

WELL DATA		
Well Depth <u>76'</u>	Casing Diameter (In.) <u>10"</u>	Casing Length (Ft.) <u>56'</u>
Type of Casing <u>PVC</u>	Hole Depth <u>76'</u>	Depth to Static Water Level <u>27'</u>

LOG DATA	
TYPE OF LOG RUN (Circle One): Electric, Gamma Ray, Density, Sonic, <u>No Log Run</u> , Neutron, Other (Describe) _____	
Name of Organization Running Log	

TYPE OF COMPLETION: (Circle One or More): <u>Gravel Packed</u> , Underreamed, Telescoped, Natural Development, Open Hole, Other	
WELL GROUTED TO A DEPTH OF <u>10</u> FEET Type Grout (circle one): Cement, <u>Bentonite</u> or Mix	

GEOLOGIC DATA (Office Use Only)			
Surface Elev.	Geologic Unit	Unit Thickness	Depth to Top
Subs. SWL	Date	Analysis	Aquifer Test

SCREEN DATA		
Diameter - Inches <u>10"</u>	Length - Feet <u>20'</u>	Slot Size - Inches <u>.032</u>
Screen Type <u>PVC</u>	Depth to Bottom - Feet <u>76'</u>	


Driller's Remarks

DESCRIPTION OF FORMATIONS ENCOUNTERED	FROM	TO
<u>Clay</u>	<u>0</u>	<u>23</u>
<u>sand + gravel</u>	<u>23</u>	<u>76</u>

FORMATIONS (Continued)	FROM	TO
RECEIVED		
JAN 16 1995		
Dept. of Environmental Quality Office of Land & Water Resources		
IF MORE SPACE IS NEEDED, USE BACK		

If well telescopes please sketch and show depths.

GROUND LEVEL

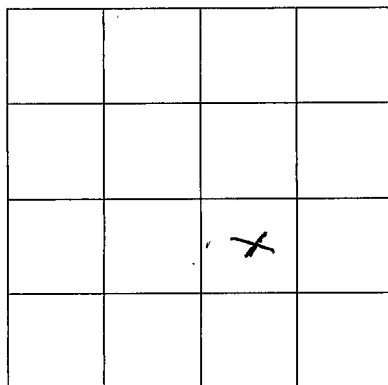

SECTION 27

Please indicate well location X.

ADDITIONAL INFORMATION

If more than one screen,
show location of each on sketch.