

MISSISSIPPI DEPARTMENT OF ENVIRONMENTAL QUALITY

Office of Land and Water Resources

P. O. Box 10631
Jackson, MS 39289-0631
WATER WELL DRILLERS LOG

COUNTY WELL LOCATED <u>Washington</u>	
WELL NUMBER <u>CA 2146</u>	CODED
DATE WELL COMPLETED <u>4-14-97</u>	

PERMIT NUMBER
NAME OF DRILLING FIRM <u>Schudco Ltd</u>

NAME & MAILING ADDRESS OF LANDOWNER <u>SPRAGINS FARMS</u>		
<u>54 Refugee Rd.</u>		
<u>Greenville Ms 38701</u>		
WELL LOCATION: SEC	TOWNSHIP	RANGE
<u>7</u>	<u>17</u>	<u>S 9</u>
DISTANCE	DIRECTION	NEAREST TOWN
<u>4</u> Miles	<u>SW</u>	of <u>Greenville</u>
OTHER LANDMARK		
WELL PURPOSE: Home, Irrigation, Municipal, Industrial, Fish Pond (etc)		

PUMP DATA		
PUMP TYPE (Circle One): <u>Submersible</u> , Turbine, Jet, Flowing Well, Other (Describe)		
POWER TYPE (Circle One): <u>Electric</u> , Tractor, Diesel, Gasoline, Butane, Other (Describe) <u>H/P 3</u>		
Pump Capacity (GPM) <u>50</u>	No. of Stages	Setting Depth <u>60</u> FT.
PUMP TEST		
Well yielded _____ GPM with a drawdown of _____ ft. after _____ hours of pumping		

WELL DATA		
Well Depth <u>100</u>	Casing Diameter (In.) <u>4</u>	Casing Length (Ft.) <u>50</u>
Type of Casing <u>pvc</u>	Hole Depth <u>100</u>	Depth to Static Water Level <u>4ft</u>
TYPE OF COMPLETION: (Circle One or More): <u>Gravel Packed</u> , Underreamed, Telescoped, Natural Development, Open Hole, Other (Describe)		

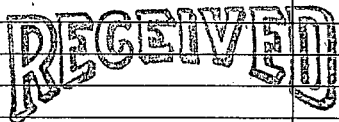
LOG DATA	
TYPE OF LOG RUN (Circle One): Electric, Gamma Ray, Density, Sonic, <u>No Log Run</u> , Neutron, Other (Describe)	
Name of Organization Running Log	

WELL GROUTED TO A DEPTH OF <u>10</u> FEET Type Grout (circle one): Cement, <u>Bentonite</u> , or Mix

GEOLOGIC DATA (Office Use Only)			
Surface Elev.	Geologic Unit	Unit Thickness	Depth to Top
Subs. SWL	Date	Analysis	Aquifer Test

SCREEN DATA		
Diameter - Inches <u>4</u>	Length - Feet <u>20</u>	Slot Size - Inches <u>.008</u>
Screen Type <u>pvc</u>	Depth to Bottom - Feet <u>100</u>	

Driller's Remarks

DESCRIPTION OF FORMATIONS ENCOUNTERED	FROM	TO	FORMATIONS (Continued)	FROM	TO
<u>Top soil & Gumbo</u>	<u>0</u>	<u>22</u>	 MAY 09 1997 Dept. of Environmental Quality Office of Land & Water Resources		
<u>fine sand</u>	<u>22</u>	<u>60</u>			
<u>med to coarse</u>	<u>60</u>	<u>80</u>			
<u>Coarse sand</u>	<u>80</u>	<u>100</u>			

IF MORE SPACE IS NEEDED, USE BACK

If well telescopes please sketch and show depths.

GROUND LEVEL

X			

SECTION 7

Please indicate well location X.

ADDITIONAL INFORMATION

If more than one screen,
show location of each on sketch.