

MISSISSIPPI DEPARTMENT OF ENVIRONMENTAL QUALITY

**RECEIVED**  
 DEPT. OF ENVIRONMENTAL QUALITY  
 OFFICE OF LAND AND WATER RESOURCES  
 JACKSON, MISSISSIPPI

P. O. Box 10631  
 Jackson, MS 39289-0631  
**WATER WELL DRILLERS LOG**

COUNTY WELL LOCATED <u>Washington</u>
WELL NUMBER <u>G 2151</u>
DATE WELL COMPLETED <u>10-4-99</u>

PERMIT NUMBER
NAME OF DRILLING FIRM <u>Schudco Ltd</u>

NAME & MAILING ADDRESS OF LANDOWNER <u>PATRICKSTHAME CENTER</u>			
<u>Greenville MS</u>			
<u>(Johnny Sides)</u>			
WELL LOCATION: SEC	TOWNSHIP	RANGE	
<u>26</u>	<u>17</u>	<u>8</u>	<u>(W)</u>
DISTANCE	DIRECTION	NEAREST TOWN	
<u>3</u> Miles	<u>South</u>	of <u>Greenville</u>	
OTHER LANDMARK			
WELL PURPOSE <input checked="" type="checkbox"/> Home Irrigation, Municipal, Industrial, Fish Pond, etc.			

PUMP DATA		
PUMP TYPE (Circle One): <input checked="" type="radio"/> Submersible, <input type="radio"/> Turbine, <input type="radio"/> Jet, <input type="radio"/> Flowing Well, Other (Describe) _____		
POWER TYPE (Circle One): <input checked="" type="radio"/> Electric, <input type="radio"/> Tractor, <input type="radio"/> Diesel, <input type="radio"/> Gasoline, <input type="radio"/> Butane, Other (Describe) _____ H/P <u>4</u>		
Pump Capacity (GPM) <u>20</u>	No. of Stages <u>7</u>	Setting Depth <u>80</u> FT.
PUMP TEST		
Well yielded _____ GPM with a drawdown of _____ ft. after _____ hours of pumping		

WELL DATA		
Well Depth <u>380</u>	Casing Diameter (in.) <u>4x2</u>	Casing Length (ft.) <u>360</u>
Type of Casing <u>pvc</u>	Hole Depth <u>380</u>	Depth to Static Water Level <u>31</u>
TYPE OF COMPLETION: (Circle One or More): <input type="checkbox"/> Gravel Packed, <input type="checkbox"/> Underreamed, <input type="checkbox"/> Telescoped, <input checked="" type="checkbox"/> <u>Natural Development</u> , <input type="checkbox"/> Open Hole, <input type="checkbox"/> Other (Describe) _____		
WELL GROUTED TO A DEPTH OF <u>10</u> FEET Type Grout (circle one): Cement, Bentonite, or Mix		

LOG DATA	
TYPE OF LOG RUN (Circle One): <input checked="" type="radio"/> <u>No Log Run</u> , <input type="radio"/> Electric, <input type="radio"/> Gamma Ray, <input type="radio"/> Density, <input type="radio"/> Sonic, <input type="radio"/> Neutron, Other (Describe) _____	
Name of Organization Running Log	

SCREEN DATA		
Diameter - Inches <u>2</u>	Length - Feet <u>20</u>	Slot Size - Inches <u>.008</u>
Screen Type <u>pvc</u>	Depth to Bottom - Feet <u>380</u>	


GEOLOGIC DATA (Office Use Only)			
Surface Elev.	Geologic Unit	Unit Thickness	Depth to Top
Subs. SWL	Date	Analysis	Aquifer Test
Driller's Remarks			
Top of Lap Pipe or Reduction in Casing			
FEET		IF TELESCOPED OR MORE THAN ONE SCREEN: USE BACK PAGE	

DESCRIPTION OF FORMATIONS ENCOUNTERED	FROM	TO	FORMATIONS (Continued)	FROM	TO
<u>Gumbo</u>	<u>0</u>	<u>40</u>			
<u>sand + little p-gravel</u>	<u>40</u>	<u>96</u>			
<u>@ clay</u>	<u>96</u>	<u>160</u>			
<u>sand + clay streaks</u>	<u>160</u>	<u>220</u>			
<u>sand</u>	<u>220</u>	<u>380</u>			

IF MORE SPACE IS NEEDED, USE BACK

If well telescopes please sketch and show depths.

GROUND LEVEL

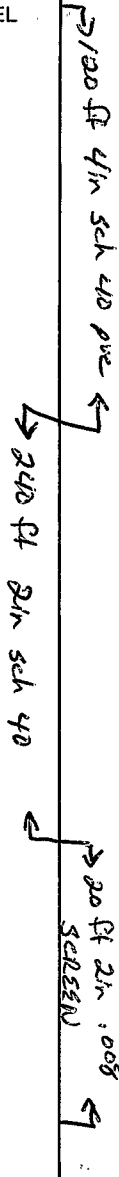

X			

SECTION 26

Please indicate well location X.

ADDITIONAL INFORMATION

If more than one screen, show location of each on sketch.