

Washington  
H  
9-19-75

MISSISSIPPI  
BOARD OF WATER COMMISSIONERS  
416 North State Street  
Jackson, Mississippi 39201

CODED

WATER WELL DRILLERS LOG

9-19 1975 Bailey Drilling Co. Washington  
date well completed firm name county well located

LANDOWNER: Louis D. Munn  
Leland, Miss.  
(mailing address)  
WELL LOCATION:  
sec. 3 T 17 N R 7 E 15L  
4 miles S of Leland  
(distance) (direction) (nearest town)

description of formations encountered	from to	
	feet	feet
Pay	0	50
Sand	50	80
Gravel	80	130
Mud	130	400
Mud + Sand	400	420
Sand	420	452

WELL PURPOSE: Farm  
(home, irrigation, municipal, industrial)


- WELL COMPLETION DATA:
- (1) diameter (inches) 4 X 2
  - (2) total depth (feet) 452'
  - (3) static water level (feet) 32 below top of ground.
  - (4) casing Steel, 442  
(material) (depth)  
4 X 2 if telescope see back.  
(size)
  - (5) screen 10', 442  
(length) (depth to top)  
2", Stainless Steel  
(size) (material)
  - (6) pump 1 20  
(HP) (yield gpm)  
Electric  
(type power)
  - (7) electric log No  
(yes or no)
- (organization running log)
- (8) how well bottom plugged Back pressure valve

DRILLERS REMARKS:

RECORDED  
INDEXED  
SEP 22 1975  
MISS. BD. OF WATER COM.

If well telescopes please sketch and show depths.

GROUND LEVEL

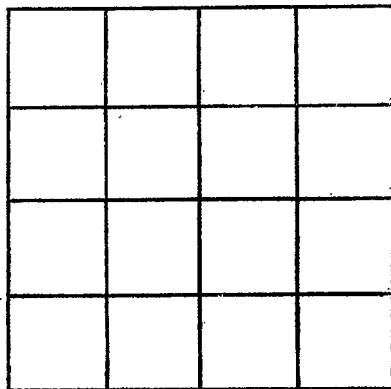

SECTION \_\_\_\_\_

Please indicate well location X.

ADDITIONAL INFORMATION

If more than one screen, show locations of each on sketch.