

MISSISSIPPI DEPARTMENT OF NATURAL RESOURCES

Bureau of Land and Water Resources

Southport Mall

P.O. Box 10631

Jackson, Mississippi 39209

WATER WELL DRILLERS LOG

Washington  
H

5-13

19

82 Schultz Drilling Wash.

date well completed

firm name

county well located

LANDOWNER: Aqua Farms  
Wilmont Rd.  
Greenville MS  
(mailing address)

description of formations encountered	from	to
Clay	0	30
Med. SAND	30	50
COARSE SAND	50	80

WELL LOCATION:  
sec. 28 T. 17 N R. 7 E  
S W of Arcola  
(distance) miles (direction) (nearest town)

WELL PURPOSE:  
(home, irrigation, municipal, industrial)


- WELL COMPLETION DATA:
- (1) diameter (inches) 10"
  - (2) total depth (feet) 80'
  - (3) static water level (feet) 22' below top of ground.
  - (4) casing PVC 50' (material), (depth)
  - (size) if telescope see back.
  - (5) screen 30' 50' (length), (depth to top)
  - 10" PVC slotted (size), (material)
  - (6) pump 15 (HP) 700 (yield gpm)
  - ele (type power)
  - (7) electric log NO (yes or no)
  - (organization running log)
  - (8) how well bottom plugged PVC cap

DRILLERS REMARKS:

DEPT. OF NATURAL RESOURCES  
BUREAU OF LAND & WATER RESOURCES  
MAY 24 1982  
RECEIVED

If well telescopes please sketch and show depths.

GROUND LEVEL

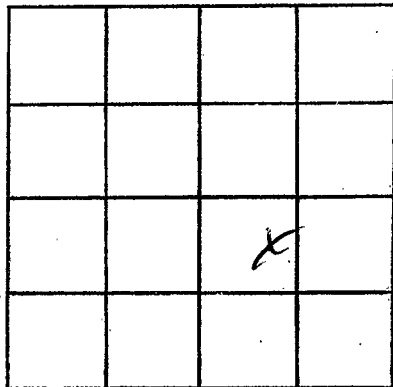

SECTION \_\_\_\_\_

Please indicate well location X.

ADDITIONAL INFORMATION

If more than one screen,  
show locations of each on sketch.