

Washington
H33
5-67

MISSISSIPPI
BOARD OF WATER COMMISSIONERS
416 North State Street
Jackson, Mississippi 39201

WATER WELL DRILLERS LOG

5/8 19 67 Dyer Well & Irrigation Washington
date well completed firm name county well located

LANDOWNER: Leon Lumley
Greenville,
Miss.
(mailing address)


WELL LOCATION:
sec. 30 T 17 N R 7 E
S W
4 miles N. E. of Wayside
(distance) (direction) (nearest town)

WELL PURPOSE: Irrigation
(home, irrigation, municipal, industrial)

WELL COMPLETION DATA:

- (1) diameter (inches) 16"
- (2) total depth (feet) 80
- (3) static water level (feet) 10 below above top of ground.
- (4) Blk. Iron casing 16" (material), 60 Ft. (depth),
if telescope see back.
(size)
- (5) screen 20 (length), 60 (depth to top)
16" Blk. Iron Doerr (size) (material)
- (6) pump 50 (HP), 1,500 (yield gpm)
Elec. (type power)
- (7) electric log No (yes or no)
(organization running log)
- (8) how well bottom plugged Plate welded on bottom


description of fomations encountered	from	to
Clay	0	23
Fine Sand	23	53
Med. Sand	53	63
Coarse Sand	63	79
Blue Clay	79	83

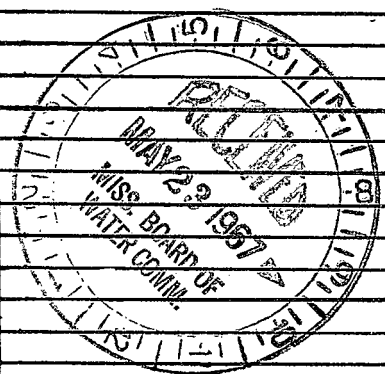

DRILLERS REMARKS:

If well telescopes please sketch and show depths.

GROUND LEVEL

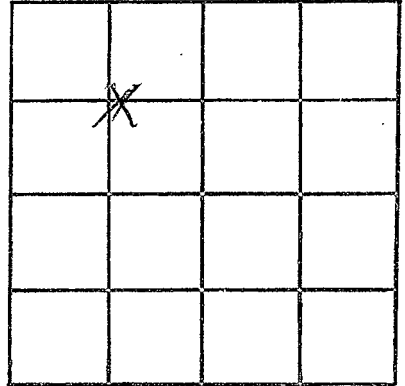

SECTION 30

Please indicate well location X.

ADDITIONAL INFORMATION

If more than one screen, show locations of each on sketch.