

WASH.

MISSISSIPPI BOARD OF WATER COMMISSIONERS

H 36
6-7-62

WATER WELL DRILLERS LOG

CODED

Date: 6/7, 1962, Driller: Boiley Mullinga County: Washington
Flanagan (Name)

(1) Owner of Land: A. B. Flanagan
(Name)
Leland, Miss.
(Address)

(2) Location: 1/4, 1/4, Sec. 2 T. R
6 miles South of Leland
(distance) (direction) (Nearest Town)

(3) Topography: Flat
(Hilly) (Flat) (Level)

(4) Purpose of Well: Domestic
(Domestic Irrigation
Municipal, Industrial, Other)

Description & Color of Materials Sand, Clay, Red Clay, Shell, etc.	Thick- ness Feet	Depth Feet
<u>Clay</u>	<u>38</u>	<u>38</u>
<u>Sand</u>	<u>32</u>	<u>70</u>
<u>Gravel & Sand</u>	<u>50</u>	<u>120</u>
<u>Mud</u>	<u>280</u>	<u>400</u>
<u>Fine Sand</u>	<u>38</u>	<u>438</u>
<u>Sand & Mud</u>	<u>9</u>	<u>447</u>
<u>Sand</u>	<u>43</u>	<u>492</u>
<u>6" rock at 285</u>		
<u>6" " at 380</u>		

Information upon completion of well:

(1) Diameter 4x2 1/2 inches.

(2) Total Depth 492 feet.

(3) Water Level 21 feet below top of ground.

(4) Cased to all way size 4x2 1/2

(5) Screen: Size 30 2 1/2 Length 30 ft


(6) Were any formations sealed against pollution?
_____ yes, X no.

If YES depth of formation _____

Why _____

Drillers Remarks: _____

CODED

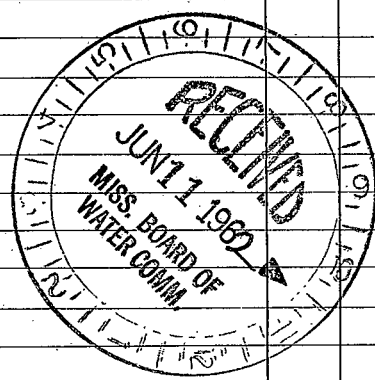

(Use Back Side)

Well No.

