

WASH.

H 37

2-26-64

WATER WELL DRILLERS LOG

CODED

Date: 2/26, 1964, Driller: Bailey Drlg. Co. County: Washington
 (Name)

(1) Owner of Land: Clyde Gault
 (Name)
Leland, Miss.
 (Address)

(2) Location: 1/4, 1/4, Sec 11, T 7N, R 7W
4 miles South of Leland
 (distance) (direction) (Nearest Town)

(3) Topography: Flat
 (Hilly) (Flat) (Level)

(4) Purpose of Well: Domestic
 (Domestic Irrigation
 Municipal, Industrial, Other)

Description & Color of Materials Sand, Clay, Red Clay, Shell, etc.	Thick-ness Feet	Depth Feet
Clay		35
Sand		100
Gravel		165
Mud		240
Sand & mud		375
Hard Sand		395
Hard mud		400
Sand		425

Information upon completion of well:

(1) Diameter 4 X 2 inches.

(2) Total Depth 425 feet.

(3) Water Level 23 feet below top of ground.

(4) Cased to all way, Size 4 X 2.

(5) Screen: Size 2", Length 20 ft.


(6) Were any formations sealed against pollution?
 _____ yes, X no.

CODED

If YES depth of formation _____

Why _____

Drillers Remarks: _____

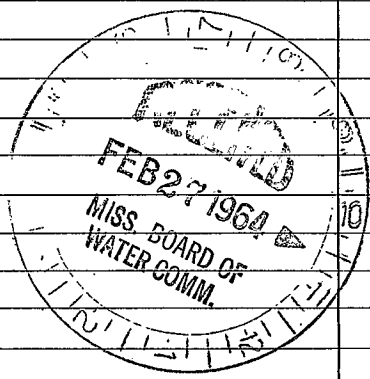

Well No.

(Use Back Side)

