

9/16/69

Jm
Well #1
C30195
LOGGED

Washington
H 42
9-10-69

MISSISSIPPI
BOARD OF WATER COMMISSIONERS
416 North State Street
Jackson, Mississippi 39201
WATER WELL DRILLERS LOG


September 10, 1969 Layne-Central Company Washington
date well completed firm name county well located

LANDOWNER: Aqua Farms, Inc.	description of formations encountered	from	to
	Fine sandy clay	16	28
Arcola, Mississippi	Coarse sand	28	38
(mailing address)	Coarse sand	38	55
WELL LOCATION:	Coarse sand, pea gravel		
sec. 30 T 17 N R 7 EX W	some gravel	55	87
6 miles west of Wilmott	Clay		87
(distance) (direction) (nearest town)			
WELL PURPOSE: irrigation			
(home, irrigation, municipal, industrial)			
WELL COMPLETION DATA:			
(1) diameter (inches) 16			
(2) total depth (feet) 95			
(3) static water level (feet) 14 xxxx above top of ground.			
(4) casing steel 55'			
(material) (depth)			
16" If telescope see back.			
(size)			
(5) screen 40' 95'			
(length) (depth to top)			
16" Armco			
(size) (material)			
(6) pump 30 1800			
(HP) (yield gpm)			
electric			
(type power)			
(7) electric log no			
(yes or no)			
(organization running log)			
(8) how well bottom plugged plate			
DRILLERS REMARKS:			

70
MISSISSIPPI
BOARD OF
WATER COMMISSIONERS

If well telescopes please sketch and show depths.

GROUND LEVEL

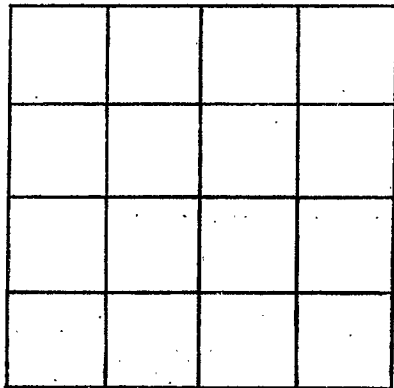

SECTION 30

Please indicate well location X.

ADDITIONAL INFORMATION

If more than one screen,
show locations of each on sketch.