

CODED

9/16/69
JW
CODED

MISSISSIPPI
BOARD OF WATER COMMISSIONERS
416 North State Street
Jackson, Mississippi 39201

Well #2274
C3019

WATER WELL DRILLERS LOG

September 13, 1969 Layne-Central Company Washington
date well completed firm name county well located

LANDOWNER: Aqua Farms, Inc.

| description of fomations encountered | from | to |
|--------------------------------------|------|----|
| Clay | 0 | 18 |
| Sand, coarse | 18 | 35 |
| Coarse sand with pea gravel | 35 | 85 |
| Gravel | 85 | 94 |

Arcola, Mississippi
(mailing address)

WELL LOCATION:

sec 30 T17N R7XXX
W
6 miles west of Wilmott
(distance) (direction) (nearest town)

WELL PURPOSE: Irrigation
(home, irrigation, municipal, industrial)

WELL COMPLETION DATA:

- (1) diameter (inches) 16
- (2) total depth (feet) 102
- (3) static water level (feet) 16' ~~above~~ above top of ground.
- (4) casing steel, 62' (material), (depth)
16" (size) if telescope see back.
- (5) screen 40' (length), 102' (depth to top)
16" (size), Armco (material)
- (6) pump 30 (HP), 1800 (yield gpm)
electric (type power)
- (7) electric log no (yes or no)
(organization running log)
- (8) how well bottom plugged plate


DRILLERS REMARKS:

SEP 19 1969

MISS. BD. OF
WATER COMMISSIONERS

If well telescopes please sketch and show depths.

GROUND LEVEL

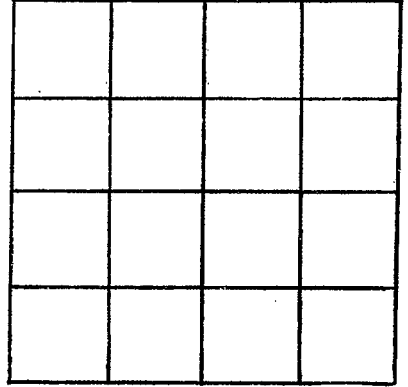

SECTION 30

Please indicate well location X.

ADDITIONAL INFORMATION

If more than one screen, show locations of each on sketch.