

Washington
H44
9-16-69

MISSISSIPPI
 BOARD OF WATER COMMISSIONERS
 416 North State Street
 Jackson, Mississippi 39201

CODED

CODED

CODED

WATER WELL DRILLERS LOG

date well completed 9/16 1969 firm name Bailey Drilling Co county well located Washington

LANDOWNER: Theodore Ford
Arcola, Miss.

description of formations encountered	from	to
<u>Clay</u>	<u>0</u>	<u>30</u>
<u>Sand</u>	<u>30</u>	<u>60</u>
<u>Gravel</u>	<u>60</u>	<u>70</u>
<u>Mud</u>	<u>70</u>	<u>450</u>
<u>Sand</u>	<u>450</u>	<u>500</u>

(mailing address)

WELL LOCATION:
 sec. 33 T 17 N R. 7 E
3 miles W of Arcola
 (distance) (direction) (nearest town)

WELL PURPOSE: Home
 (home, irrigation, municipal, industrial)

- WELL COMPLETION DATA:
- (1) diameter (inches) 2"
 - (2) total depth (feet) 500
 - (3) static water level (feet) 16 below top of ground.
 - (4) casing Steel, 495'
 (material) (depth)
2" If telescope see back.
 (size)
 - (5) screen 5', 495'
 (length) (depth to top)
2", Stainless Steel
 (size) (material)
 - (6) pump 1/2, 5
 (HP) (yield gpm)
Elec
 (type power)
 - (7) electric log no
 (yes or no)
- (organization running log)

(8) how well bottom plugged Back pressure valve


DRILLERS REMARKS:

SEP 17 1969

MISS. REG. ENG. CONTRACTORS

If well telescopes please
sketch and show depths.

GROUND LEVEL

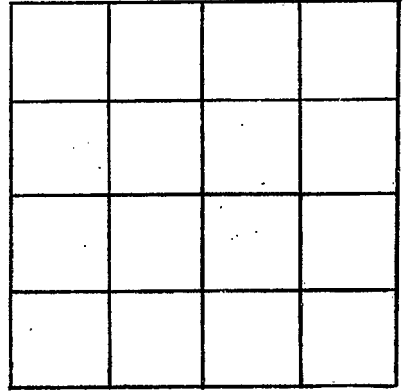

SECTION 33

Please indicate well location X.

ADDITIONAL INFORMATION

If more than one screen,
show locations of each on sketch.