

INDEXED  
INDEXED  
INDEXED

5/28/68  
JW  
E2660

Washington  
H 45  
5-9-68

MISSISSIPPI  
BOARD OF WATER COMMISSIONERS  
416 North State Street  
Jackson, Mississippi 39201

WATER WELL DRILLERS LOG

May 9, 1968 Layne-Central Company Washington  
date well completed firm name county well located

LANDOWNER: W. C. Skates, Jr.

description of formations encountered from to

Clay 0 16  
Fine black sand 16 28  
Fine sand, clay balls 28 34  
Fine sand, old wood 34 58  
Coarse sand, pea gravel 58 92

Avon, Mississippi  
(mailing address)

WELL LOCATION:

sec 5 T. 17 N R. 9 E  
4 miles west of Arcola  
(distance) (direction) (nearest town)

WELL PURPOSE: Irrigation  
(home, irrigation, municipal, industrial)

WELL COMPLETION DATA:


- (1) diameter (inches) 16
- (2) total depth (feet) 92
- (3) static water level (feet) 12 ~~above~~ above top of ground.
- (4) casing steel, 62'  
(material), (depth)  
16" if telescope see back.  
(size)
- (5) screen 30', 92'  
(length), (depth to top)  
16", Armco  
(size), (material)
- (6) pump 25, 1500  
(HP), (yield gpm)  
electric  
(type power)
- (7) electric log no  
(yes or no)  
(organization running log)
- (8) how well bottom plugged plate

MAY 31 1968  
MISS. BOARD OF  
WATER COMM.

DRILLERS REMARKS:

If well telescopes please sketch and show depths.

GROUND LEVEL

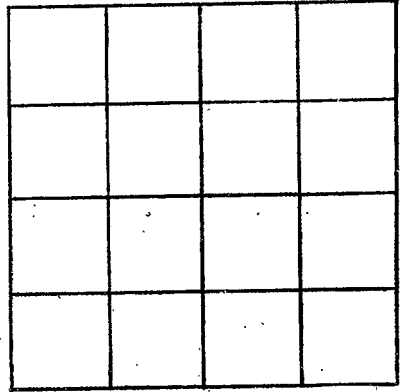

SECTION \_\_\_\_\_

Please indicate well location X.

ADDITIONAL INFORMATION

If more than one screen, show locations of each on sketch.