

Washington
H 46
7-30-70

MISSISSIPPI
BOARD OF WATER COMMISSIONERS
416 North State Street
Jackson, Mississippi 39201

9/21/70
CODED
C325
Well #1

WATER WELL DRILLERS LOG

July 30, 19 70 SINGER-Layne Central Division Washington
date well completed firm name county well located

LANDOWNER: Aqua Farms, Inc.	description of formations encountered	from	to
	Coarse sand	20	35
Arcola, Mississippi (mailing address)	Coarse sand, some gravel	35	80
	Hard white clay		80
WELL LOCATION:			
sec. 30 T 17 N R. 7 E X W			
3 miles west of Wilmont (distance) (direction) (nearest town)			
WELL PURPOSE: irrigation (home, irrigation, municipal, industrial)			
WELL COMPLETION DATA:			
(1) diameter (inches) 16			
(2) total depth (feet) 80			
(3) static water level (feet) 21' below top of ground			
(4) casing steel 40' (material) (depth)			
16" if telescope see back. (size)			
(5) screen 40' 80' (length) (depth to top)			
16" Armco (size) (material)			
(6) pump 30 1800 (HP) (yield gpm)			
electric (type power)			
(7) electric log no (yes or no)			
(organization running log)			
(8) how well bottom plugged plate			
DRILLERS REMARKS:			


CODED

SEP 22 1970

MISS. Bd. of
Water Comm.

If well telescopes please
sketch and show depths.

GROUND LEVEL

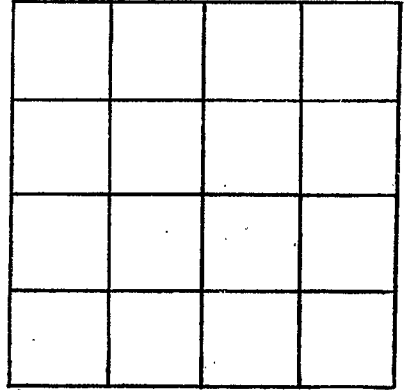

SECTION _____

Please indicate well location X.

ADDITIONAL INFORMATION

If more than one screen,
show locations of each on sketch.