

Washington
H 47
6-16-70

MISSISSIPPI
BOARD OF WATER COMMISSIONERS
416 North State Street
Jackson, Mississippi 39201

CODED

WATER WELL DRILLERS LOG

6/16 1970 Bailey Drilling Co. Washington
date well completed firm name county well located

LANDOWNER: J. E. Bennett
Leland, Miss

description of formations encountered	from	to
<u>Clay</u>	<u>0</u>	<u>20</u>
<u>Sand</u>	<u>20</u>	<u>66</u>
<u>Gravel</u>	<u>66</u>	<u>67</u>

(mailing address)

WELL LOCATION:
sec. 10 T. 170 R. 7
5 miles S of Leland
(distance) (direction) (nearest town)

WELL PURPOSE: Home
(home, irrigation, municipal, industrial)

- WELL COMPLETION DATA:
- (1) diameter (inches) 2"
 - (2) total depth (feet) 67'
 - (3) static water level (feet) 16 below above top of ground.
 - (4) casing Steel 63'
(material) (depth)
2" If telescope see back.
(size)
 - (5) screen 4' 63'
(length) (depth to top)
2" Stainless Steel
(size) (material)
 - (6) pump 1/2 6
(HP) (yield gpm)
Elec
(type power)
 - (7) electric log No
(yes or no)

CODED

JUN 18 1970


MISS. BD. OF
WATER COMM.

(8) how well bottom plugged: Back pressure valve

DRILLERS REMARKS:

If well telescopes please sketch and show depths.

GROUND LEVEL

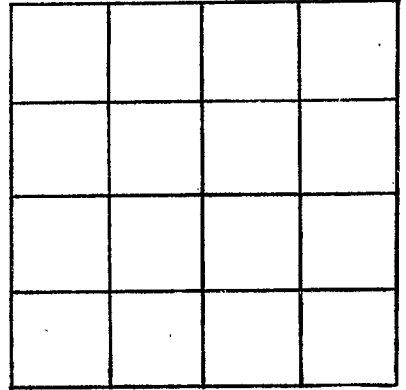

SECTION _____

Please indicate well location X.

ADDITIONAL INFORMATION

If more than one screen,
show locations of each on sketch.