

Washington
 H-51
 8-59

MISSISSIPPI BOARD OF WATER COMMISSIONERS

Case 7/9/69 JAC

1/14/66
 751
CODED

WATER WELL DRILLERS LOG

Date: Aug. 21, 1959, Driller: Layne-Central Company Washington County

(Name)

- (1) Owner of Land: L.L. Paxton
 (Name)
Leland, Mississippi 17-2
 (Address)
20 19 NW
- (2) Location: 1/4, 1/4, Sec. T, R. R
5 miles south of Leland
 (distance) (direction) (Nearest Town)
- (3) Topography: flat
 (Hilly) (Flat) (Level)
- (4) Purpose of Well: industrial
 (Domestic Irrigation
 Municipal, Industrial, Other)

Description & Color of Materials Sand, Clay, Red Clay, Shell, etc.	Thick- ness Feet	Depth Feet
Clay	24	24
Fine sand	26	50
Coarse sand	25	75
Coarse sand & pea gravel	65	140
Clay	6	146
Sand	24	170
Clay	33	203
Shale with sandy shale	57	260
Fine sand & shale	95	355
Shale	80	435
Sand	15	450
Clay	20	470
Shale, strks. of sand	30	500
Fine sand	15	515
Sand	53	568

Information upon completion of well:

- (1) Diameter 3x2 1/2 inches.
- (2) Total Depth 568 feet.
- (3) Water Level 22'9" feet below top of ground.
- (4) Cased to 535', Size 3"
10" swage
- (5) Screen: Size 2 1/2", Length 30'
3' of 2 1/2" blank
- (6) Were any formations sealed against pollution?
yes yes, no no.


If YES depth of formation Packer above the
screen and B.P.V.

Why _____

Drillers Remarks: _____

15 GPM.

CODED

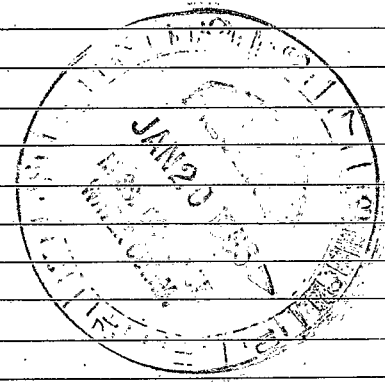

(Use Back Side)

Well No.

100

100

