

WASHINGTON  
1454  
3-10-71

MISSISSIPPI  
BOARD OF WATER COMMISSIONERS  
416 North State Street  
Jackson, Mississippi 39201

CODED

WATER WELL DRILLERS LOG

3-10 1971 Schultz Drilling Washington  
date well completed firm name county well located

LANDOWNER:	Description of formations encountered	from	to
Frank Blumstein	Clay	0	22
Salina Miss (mailing address)	SAND	22	79
WELL LOCATION: sec. 9 T. 17 N R. 7 E 4 miles South of Salina	Clay	79	182
(distance) (direction) (nearest town)	Sandy Shale	182	210
WELL PURPOSE: Home	Sand	210	265
(home, irrigation, municipal, industrial)	Clay	265	269
WELL COMPLETION DATA:	Sand	269	319
(1) diameter (inches) 4" x 2"	Clay	319	323
(2) total depth (feet) 440	Sand	323	358
(3) static water level (feet) 26 below top of ground.	Clay	358	368
(4) casing (material) (depth) (size) if telescope see back.	SAND	368	460
(5) screen 20 (length) (depth to top) 24 (size) 4 (material)	Clay	460	
(6) pump 1 (HP) 25 (yield gpm) (type power)			
(7) electric log (yes or no)			
(organization running log)			
(8) how well bottom plugged			
DRILLERS REMARKS:			

CODED

MAR 30 1971

MISS. BD. OF WATER COMMISSIONERS


If well telescopes please sketch and show depths.

GROUND LEVEL

105 ft  
4"

55 ft  
2"

30 ft  
Screen

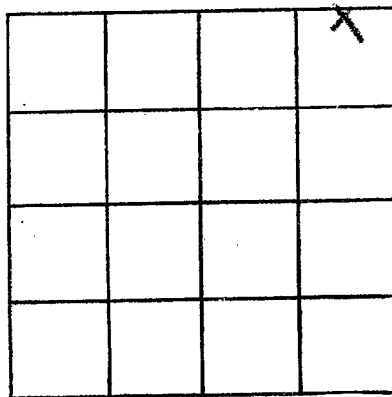

SECTION 9

Please indicate well location X.

ADDITIONAL INFORMATION

If more than one screen, show locations of each on sketch.