

WASHINGTON  
H 56  
8-16-71

MISSISSIPPI  
BOARD OF WATER COMMISSIONERS  
416 North State Street  
Jackson, Mississippi 39201

**CODED**

CI4050-3569

WATER WELL DRILLERS LOG

August 16, 1971 SINGER-Layne Central Division Washington  
date well completed firm name county well located

LANDOWNER:	description of formations encountered	from	to
Aqua Farms, Inc.	Clay	0	25
Arcola, Mississippi	Sand	25	35
(mailing address)	Pea gravel and sand	35	80
<b>WELL LOCATION:</b>			
sec. <u>30</u> T <u>17</u> N R <u>7</u> <del>8</del> W			
<u>5</u> miles <u>NW</u> of <u>Arcola</u> (distance) (direction) (nearest town)			
<b>WELL PURPOSE:</b> <u>irrigation</u> (home, irrigation, municipal, industrial)			
<b>WELL COMPLETION DATA:</b>			
(1) diameter (inches) <u>16"</u>			
(2) total depth (feet) <u>80'</u>			
(3) static water level (feet) <u>21'9"</u> below above top of ground.			
(4) casing <u>steel</u> <u>40'</u> (material) (depth)			
<u>16"</u> (size) if telescope see back.			
(5) screen <u>40'</u> <u>80'</u> (length) (depth to top)			
<u>16"</u> <u>Armco</u> (size) (material)			
(6) pump <u>30</u> <u>1200</u> (HP) (yield gpm)			
<u>electric</u> (type power)			
(7) electric log <u>no</u> (yes or no)			
<u>(organization running log)</u>			
(8) how well bottom plugged <u>plate</u>			
<b>DRILLERS REMARKS:</b>			


**CODED**

NOV 9 - 1971

MISS. RD. OF  
WATER COMMISSIONERS

If well telescopes please sketch and show depths.

GROUND LEVEL

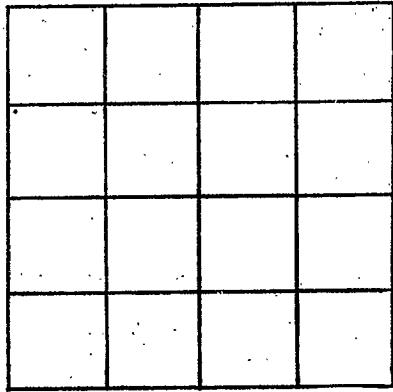

SECTION \_\_\_\_\_

Please indicate well location X.

ADDITIONAL INFORMATION

If more than one screen, show locations of each on sketch.