

WASHINGTON
H59
4-4-73

MISSISSIPPI
BOARD OF WATER COMMISSIONERS
416 North State Street
Jackson, Mississippi 39201

CONF

WATER WELL DRILLERS LOG

4-4-73 date well completed
Owens P/bg+Htg firm name
Wash county well located

LANDOWNER: HENRY BURNSIDE
Rt 2, Box 629
Greenville, MS. 38701
(mailing address)

description of formations encountered	from	to
top soil	0	22
Sand + Gravel	22	126
Clay	126	210
Sand	210	503

WELL LOCATION:
sec 19 T 17 S R 7 E
15 miles S-E of Greenville
(distance) (direction) (nearest town)

WELL PURPOSE: HOME
(home, irrigation, municipal, industrial)

CODED

- WELL COMPLETION DATA:
- (1) diameter (inches) 4" x 2"
 - (2) total depth (feet) 503'
 - (3) static water level (feet) 28' below top of ground
 - (4) casing galv. 483' (material) (depth)
 - (size) If telescope see back.
 - (5) screen 20' 503' (length) (depth to top)
2" S.S. (size) (material)
 - (6) pump 1 45 (HP) (y/field gpm)
Elec. (type power)
 - (7) electric log NO (yes or no)


APR 05 1973

(organization running log)
(8) how well bottom plugged 13/w/v

DRILLERS REMARKS: OWENS

If well telescopes please sketch and show depths.

GROUND LEVEL

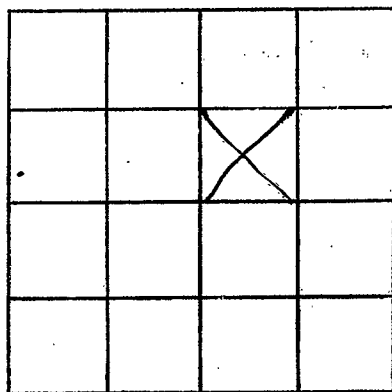

SECTION _____

Please indicate well location X.

ADDITIONAL INFORMATION

If more than one screen, show locations of each on sketch.