

WASHINGTON
H 60
7-2-74

MISSISSIPPI
BOARD OF WATER COMMISSIONERS
416 North State Street
Jackson, Mississippi 39201
WATER WELL DRILLERS LOG

CODED


July 2, 19 74 Singer-Layne Central Div. Washington
date well completed firm name county well located

LANDOWNER: Ray Kuhn	description of formations encountered	from	to
Greenville, MS 38701 (mailing address)	Clay	0	20
	Fine Sand Clay Balls	20	57
	Coarse Sand	57	78
WELL LOCATION: sec. 3 T 17 N R 7 Ex S W 7 miles Southwest Leland (distance) (direction) (nearest town)			
WELL PURPOSE: Irrigation (home, irrigation, municipal, industrial)			
WELL COMPLETION DATA:			
(1) diameter (inches) 16"			
(2) total depth (feet) 78'			
(3) static water level (feet) 12' below top of ground.			
(4) casing Steel 58' (material) (depth) 16" (size) if telescope see back.			
(5) screen 20' 78' (length) (depth to top)			
16" Steel (size) (material)			
(6) pump (HP) (yield gpm) (type power)			
(7) electric log No (yes or no)			
(organization running log)			
(8) how well bottom plugged with Plate			
DRILLERS REMARKS: Purchaser to have pump moved and set by others.			

RECEIVED
SEP 23 1974

If well telescopes please sketch and show depths.

GROUND LEVEL

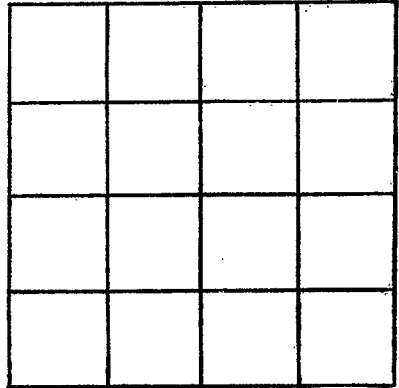

SECTION _____

Please indicate well location X.

ADDITIONAL INFORMATION

If more than one screen, show locations of each on sketch.