

WASH
H 61
11-6-74

MISSISSIPPI
BOARD OF WATER COMMISSIONERS
416 North State Street
Jackson, Mississippi 39201


CODED

WATER WELL DRILLERS LOG

11-6 date well completed
J.S. Schuster Drilling firm name
Wetumpka county well located

LANDOWNER: <u>W. C. Davis</u>	description of formations encountered	from	to
<u>Leeland Miss</u> (mailing address)			
	Clay	0	21
	SAND	21	103
WELL LOCATION: sec. <u>8</u> T. <u>17</u> N. R. <u>7</u> E <u>4</u> miles <u>S. 50</u> of <u>Leeland</u> (distance) (direction) (nearest town)	Clay	103	147
	SAND	147	163
WELL PURPOSE: <u>Home</u> (home, irrigation, municipal, industrial)	Clay & shell	163	386
WELL COMPLETION DATA:	SAND	386	460
(1) diameter (inches) <u>2 1/2</u>			
(2) total depth (feet) <u>450</u>			
(3) static water level (feet) <u>33</u> below top of ground.			
(4) casing <u>P.V.C.</u> (material) (depth)			
(size) if telescope see back.			
(5) screen <u>10</u> (length) (depth to top)			
<u>2 1/2</u> (size) <u>P.V.C.</u> (material)			
(6) pump <u>1</u> (HP) <u>10</u> (yield gpm)			
<u>Electric</u> (type power)			
(7) electric log <u>NO</u> (yes or no)			
(organization running log)			
(8) how well bottom plugged <u>Spunk</u>			

CODED

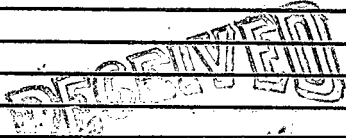


DEC 12 1974

MISS. BOARD OF WATER COMMISSIONERS

DRILLERS REMARKS:

If well telescopes please sketch and show depths.

GROUND LEVEL

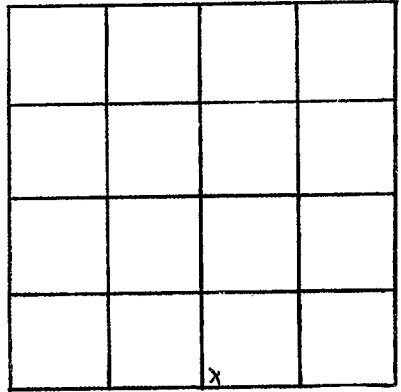

SECTION 8

Please indicate well location X.

ADDITIONAL INFORMATION

If more than one screen,
show locations of each on sketch.