

Washington
H 62
6-75

MISSISSIPPI
BOARD OF WATER COMMISSIONERS
416 North State Street
Jackson, Mississippi 39201

WATER WELL DRILLERS LOG

CODED

June 1975
date well completed

Schubert
firm name

Wool
county well located

LANDOWNER:

Stauffer Chemical
Belmont
(mailing address)

description of formations encountered

from

to

Top Soil
Sand

0 23
23 120

WELL LOCATION:

sec. 11 T 17 N R 7 E 15L
S W
4 miles S of Lelone
(distance) (direction) (nearest town)

WELL PURPOSE:

drain
(home, irrigation, municipal, industrial)

WELL COMPLETION DATA:

- (1) diameter (inches) 10"
- (2) total depth (feet) 100
- (3) static water level (feet) 20 below top of ground.
- (4) casing Steel (material), 40ft (depth)
(size) if telescope see back.
- (5) screen 20 (length), (depth to top)
10" (size), CALV (material)
- (6) pump 40 (HP), 550 (yield gpm)
Sutro (type power)
- (7) electric log (yes or no)

(organization running log)

- (8) how well bottom plugged CAP

DRILLERS REMARKS:


RECEIVED
MAY 19 1975

MAY - 2 1975

MISS. BD. OF WATER COMMISSIONERS

If well telescopes please sketch and show depths.

GROUND LEVEL

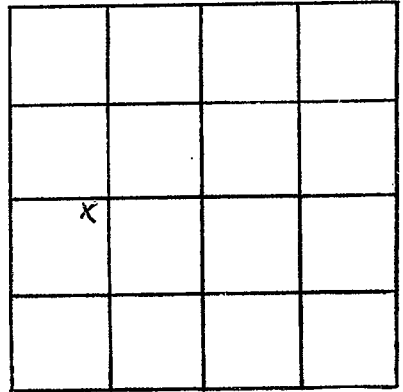

SECTION 11

Please indicate well location X.

ADDITIONAL INFORMATION

If more than one screen,
show locations of each on sketch.