

Washinton  
 H 62 603  
 9-29-75

Bill Oakley JAM  
 MISSISSIPPI 831-98  
 BOARD OF WATER COMMISSIONERS  
 416 North State Street  
 Jackson, Mississippi 39201

CODED

WATER WELL DRILLERS LOG

Sept 29 1975 Owens Rly. W.D. Wash.  
 date well completed firm name county well located

LANDOWNER: Walter Morman  
 Rt 2 Box 652 Greenville  
 Mississippi 38701  
 (mailing address)

WELL LOCATION:  
 9 sec. 9 T. 17 N. R. 7 E. 157  
 12 miles S-E of Greenville  
 (distance) (direction) (nearest town)


WELL PURPOSE:  
 (home, irrigation, municipal, industrial)

WELL COMPLETION DATA:

- (1) diameter (inches) 2"
- (2) total depth (feet) 441'
- (3) static water level (feet) 18' below top of ground.
- (4) casing steel 431' (material) (depth)
- (size) If telescope see back.
- (5) screen 10' 441' (length) (depth to top)
- 2" steel (size) (material)
- (6) pump 1 18 (HP) (yield gpm)
- Electric (type power)
- (7) electric log no (yes or no)
- (organization running log)
- (8) how well bottom plugged S.B.

description of formations encountered	from	to
top soil	0	30
Sand	30	93
Clay	93	177
Sand + gravel	177	284
Drill	282	441

CODED

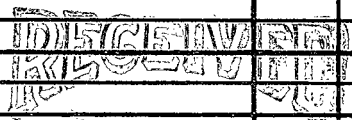


OCT - 8 1975

MISS. BU. OF WATER COMM.

DRILLERS REMARKS: D.M.M.

If well telescopes please sketch and show depths.

GROUND LEVEL

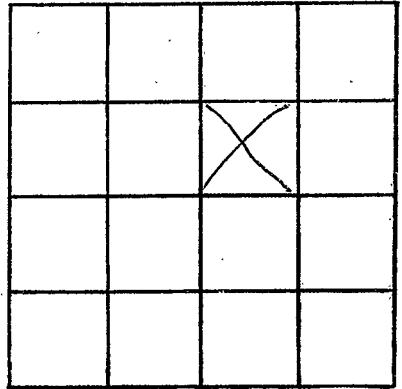

SECTION \_\_\_\_\_

Please indicate well location X.

ADDITIONAL INFORMATION

If more than one screen, show locations of each on sketch.