

WASH.
H 6A
3-25-77

MISSISSIPPI
BOARD OF WATER COMMISSIONERS CODED
416 North State Street
Jackson, Mississippi 39201
WATER WELL DRILLERS LOG


March 25 1977 Bruce Berryman - WASHINGTON
date well completed firm name county well located
Greenwood, Miss.

LANDOWNER: Carey Prather	description of formations encountered	from	to
Rt. 2, Box 181, Leland, Miss. 38756 (mailing address)			
	Sand	20	60
	Sand & gravel	60	190
	Clay	190	260
	Sand	260	400
	Clay	400	420
	Sand	420	500
	Shale	500	505
	Sand	505	520
	Sand & str. shale	520	540
	Sand	540	580
WELL LOCATION:			
sec. 35 T 17 N R 7 W	CODED		
8 miles S of LELAND (distance) (direction) (nearest town)			
WELL PURPOSE: Home (home, irrigation, municipal, industrial)			
WELL COMPLETION DATA:			
(1) diameter (inches) 4" x 2"			
(2) total depth (feet) 567'			
(3) static water level (feet) 21' below top of ground			
(4) casing 4" blk. - 105'			
(material) 2" galy. - 441'			
(depth)			
(size) If telescope see back.			
(5) screen 20' 547'			
(length) (depth to top)			
.010 stainless steel			
(size) (material)			
(6) pump 2 h.p. 40			
(HP) (yield gpm)			
Electric			
(type power)			
(7) electric log NO			
(yes or no)			
(organization running log)			
(8) how well bottom plugged B.P.V.			
DRILLERS REMARKS:			

RECEIVED
APR 7 1977
MISS. BO. OF WATER COMMISSIONERS

If well telescopes please sketch and show depths.

GROUND LEVEL

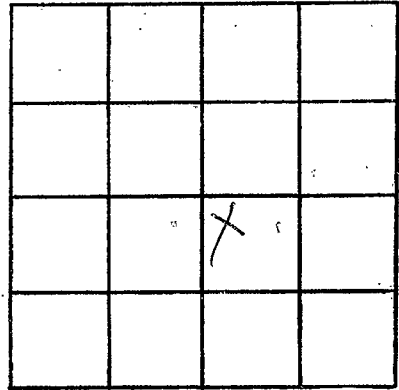

SECTION 25

Please indicate well location X.

ADDITIONAL INFORMATION

If more than one screen,
show locations of each on sketch.