

WASHINGTON  
 H65  
 C-11-77

MISSISSIPPI  
 BOARD OF WATER COMMISSIONERS  
 416 North State Street  
 Jackson, Mississippi 39201

**CODED**

**WATER WELL DRILLERS LOG**

6-11 19 77 Layne Central Co. Washington  
 date well completed firm name county well located

LANDOWNER: J. W. Potter  
 Arcola, MS

(mailing address)

WELL LOCATION:

sec. 31 T 17 N R 7 W  
 7 miles S Ieland  
 (distance) (direction) of (nearest town)

WELL PURPOSE: Irrigation  
 (home, irrigation, municipal, industrial)

WELL COMPLETION DATA:

- (1) diameter (inches) 16"
- (2) total depth (feet) 95'
- (3) static water level (feet) 29' below top of ground.
- (4) casing steel 74'  
 (material) (depth)  
16"  
 (size) If telescope see back.
- (5) screen 21' 74'  
 (length) (depth to top)  
12" St. Steel  
 (size) (material)
- (6) pump 30 1200  
 (HP) (yield gpm)  
diesel  
 (type power)
- (7) electric log No  
 (yes or no)  
 (organization running log)
- (8) how well bottom plugged Steel Pl.

description of formations encountered	from	to
Clay	0	25
fine sand	25	46
med. coarse sand	46	51
coarse sand & clay balls	51	54
fine sand	65	71
med. coarse sand	71	79
coarse sand & gravel	79	95
clay	95	97

**CODED**


**RECEIVED**

AUG 8 1977

DRILLERS REMARKS:

If well telescopes please sketch and show depths.

GROUND LEVEL

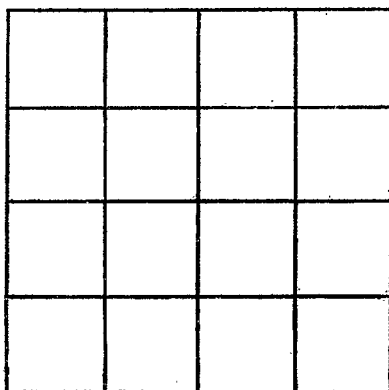

SECTION \_\_\_\_\_

Please indicate well location X.

ADDITIONAL INFORMATION

If more than one screen,  
show locations of each on sketch.