

WASHINGTON
H 66
5-29-77

MISSISSIPPI
BOARD OF WATER COMMISSIONERS
416 North State Street
Jackson, Mississippi 39201
WATER WELL DRILLERS LOG

CODED

5-29 1977 Layne Central Co. Washington
date well completed firm name county well located

LANDOWNER: Aqua Farms
Arcola, MS
(mailing address)

description of formations encountered	from	to
Clay	0	41
Fine Sand	41	64
coarse sand	64	82
clay	82	

#2 WELL LOCATION:
sec. 30 T. 17 N R. 7 W
6 miles South of Ieland
(distance) (direction) (nearest town)

CODED

WELL PURPOSE: Irrigation
(home, irrigation, municipal, industrial)

WELL COMPLETION DATA:

- (1) diameter (inches) 12"
- (2) total depth (feet) 82'
- (3) static water level (feet) 29' below top of ground.
- (4) casing Steel 79' (material) (depth)
12" (size) If telescope see back.
- (5) screen 15' 67' (length) (depth to top)
10" St. Steel (size) (material)
- (6) pump 20 700 (HP) (yield gpm)
diesel (type power)
- (7) electric log No (yes or no)

(organization running log)

(8) how well bottom plugged St. Plate

RECEIVED


AUG 8 1977

DRILLERS REMARKS:

MISS. BD. OF WATER COMMISSIONERS

If well telescopes please sketch and show depths.

GROUND LEVEL

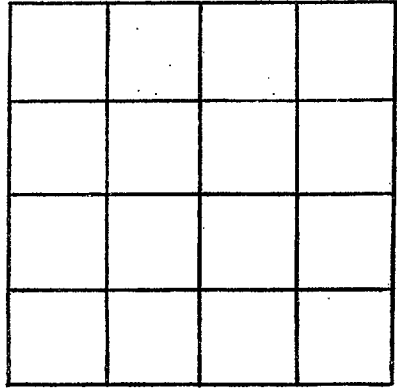

SECTION _____

Please indicate well location X.

ADDITIONAL INFORMATION

If more than one screen, show locations of each on sketch.