

WASHINGTON

H 67

6-2-77

Gw ~~7849~~ 01220

MISSISSIPPI BOARD OF WATER COMMISSIONERS  
416 North State Street  
Jackson, Mississippi 39201

CODED

WATER WELL DRILLERS LOG

6-2-1977  
date well completed

Layne Central Co.  
firm name

Washington  
county well located

LANDOWNER: Aqua Farms  
Arcola, MS

(mailing address)

description of formations encountered

from

to

Clay

0

43

Fine Sand

43

73

coarse sand

73

85

clay

85

#3 WELL LOCATION:

sec. 30 T. 17 N R. 7 W  
6 miles S of Ieland  
(distance) (direction) (nearest town)

WELL PURPOSE: Irrigation  
(home, irrigation, municipal, industrial)

CODED

WELL COMPLETION DATA:

- (1) diameter (inches) 12"
- (2) total depth (feet) 85'
- (3) static water level (feet) 26' below top of ground.
- (4) casing Steel 75'  
(material) (depth)  
12" if telescope see back.  
(size)
- (5) screen 10' 75'  
(length) (depth to top)  
10" St. Steel  
(size) (material)
- (6) pump 20 800  
(HP) (yield gpm)  
diesel  
(type power)
- (7) electric log No.  
(yes or no)

(organization running log)

(8) how well bottom plugged St. Plate

DRILLERS REMARKS:


RECEIVED

AUG 8 1977

MISS. BD. OF WATER COMMISSIONERS

If well telescopes please sketch and show depths.

GROUND LEVEL

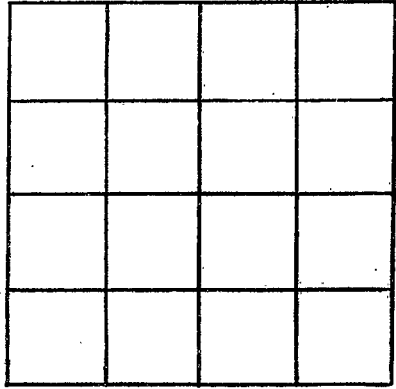

SECTION \_\_\_\_\_

Please indicate well location X.

ADDITIONAL INFORMATION

If more than one screen, show locations of each on sketch.