

WASHINGTON  
H68  
5-29-77

MISSISSIPPI  
BOARD OF WATER COMMISSIONERS  
416 North State Street  
Jackson, Mississippi 39201  
WATER WELL DRILLERS LOG

CODED

CODED

5-29 19 77 Layne Central Co. Washington  
date well completed firm name county well located

LANDOWNER: Aqua Farms  
Arcola, MS  
(mailing address)

description of formations encountered	from	to
Clay	0	42
Fine Sand	42	64
Coarse sand & Pea gravel	64	91
Clay	91	93

#4 WELL LOCATION:  
sec. 30 T. 17 N R. 7 W  
6 miles South of Leland  
(distance) (direction) (nearest town)

WELL PURPOSE: Irrigation  
(home, irrigation, municipal, industrial)

WELL COMPLETION DATA:  
(1) diameter (inches) 12"  
(2) total depth (feet) 91' 11"  
(3) static water level (feet) 32' below top of ground.  
(4) casing Steel 66' (material) (depth) 12" (size) if telescope see back.  
(5) screen 25' 66' (length) (depth to top) 10" (size) St. Steel (material)  
(6) pump 20 700 (HP) (yield gpm) diesel (type power)  
(7) electric log No (yes or no)  
(organization running log)  
(8) how well bottom plugged St. Plate

CODED

RECEIVED


AUG 8 1977

DRILLERS REMARKS:

MISS. BD. OF WATER COMMISSIONERS

If well telescopes please sketch and show depths.

GROUND LEVEL

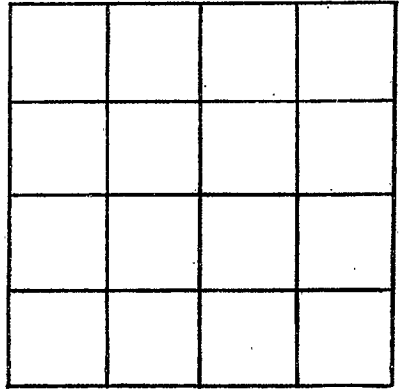

SECTION \_\_\_\_\_

Please indicate well location X.

ADDITIONAL INFORMATION

If more than one screen, show locations of each on sketch.