

WASHINGTON
 H 69
 5-14-77

MISSISSIPPI
 BOARD OF WATER COMMISSIONERS
 416 North State Street
 Jackson, Mississippi 39201

CODED

WATER WELL DRILLERS LOG

5-14 19 77 Layne Central Co. Washington
 date well completed firm name county well located

LANDOWNER: Aqua Farms
 Arcola, MS
 (mailing address)

WELL LOCATION:
 sec. 27 T. 17 N R. 7 W
 5 miles N.W. of Arcola
 (distance) (direction) (nearest town)

WELL PURPOSE: Irrigation
 (home, irrigation, municipal, industrial)

- WELL COMPLETION DATA:
- (1) diameter (inches) 12"
 - (2) total depth (feet) 79'
 - (3) static water level (feet) 26' below top of ground.
 - (4) casing Steel, 73' 10" (material), (depth)
 12" (size) if telescope see back.
 - (5) screen 12' (length), 67' (depth to top)
 10" (size), St. Steel (material)
 - (6) pump 20 (HP), 900 (yield gpm)
 diesel (type power)
 - (7) electric log No. (yes or no)
 (organization running log)
 - (8) how well bottom plugged St. Plate

description of formations encountered	from	to
	Clay	0
Fine Sand	14	66
Coarse Sand & gravel	66	78

CODED


RECEIVED
 AUG 4 1977

MISS. Bd. of WATER COMMISSIONERS

DRILLERS REMARKS:

If well telescopes please sketch and show depths.

GROUND LEVEL

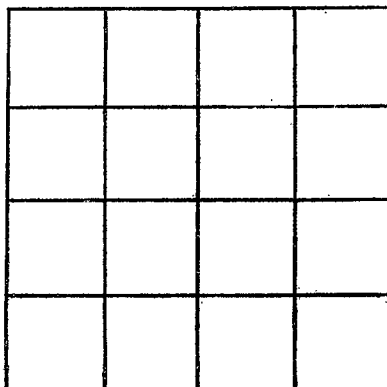

SECTION _____

Please indicate well location X.

ADDITIONAL INFORMATION

If more than one screen, show locations of each on sketch.