

WASHINGTON
H70
3-30-77

MISSISSIPPI
BOARD OF WATER COMMISSIONERS
416 North State Street
Jackson, Mississippi 39201

WATER WELL DRILLERS LOG

3-30 1977 Layne Central Co. Washington
date well completed firm name county well located

LANDOWNER: Aqua Farms Arcola, MS (mailing address)	description of formations encountered	from	to
	Clay	0	25
	Fine Sand & Clay	25	42
	Med. Fine Sand	42	58
	Coarse Sand & Pea Gr.	58	90
WELL LOCATION:			
sec. <u>27</u> T. <u>17</u> N R. <u>7</u> E W			
<u>5</u> miles <u>N.W.</u> of <u>Arcola</u> (distance) (direction) (nearest town)			
WELL PURPOSE: <u>Irrigation</u> (home, irrigation, municipal, industrial)			
WELL COMPLETION DATA:			
(1) diameter (inches) <u>16"</u>			
(2) total depth (feet) <u>90'</u>			
(3) static water level (feet) <u>25'</u> below top of ground.			
(4) casing <u>Steel</u> <u>60'</u> (material) (depth)			
<u>16"</u> if telescope see back. (size)			
(5) screen <u>30'</u> <u>60'</u> (length) (depth to top)			
<u>16"</u> <u>St. Steel</u> (size) (material)			
(6) pump <u>30</u> <u>1500</u> (HP) (yield gpm)			
<u>electric</u> (type power)			
(7) electric log <u>No</u> (yes or no)			
<u>(organization running log)</u>			
(8) how well bottom plugged <u>St. Plate</u>			
DRILLERS REMARKS:			


CODED

RECEIVED
AUG 4 1977

MISS. BD. OF WATER COMMISSIONERS

If well telescopes please sketch and show depths.

GROUND LEVEL

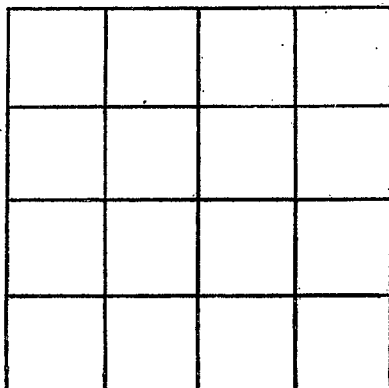

SECTION _____

Please indicate well location X.

ADDITIONAL INFORMATION

If more than one screen, show locations of each on sketch.