

WASH.
H 71
8/24/77

MISSISSIPPI
BOARD OF WATER COMMISSIONERS
416 North State Street
Jackson, Mississippi 39201

CODED

WATER WELL DRILLERS LOG

8-24 19 77 Layne Central Co. Washington
date well completed firm name county well located

LANDOWNER: Potter Bros.
Arcola, MS

(mailing address)

#2 WELL LOCATION:
1 sec. 32 T 17 N R 7 W
4 miles W of Arcola
(distance) (direction) (nearest town)

WELL PURPOSE: Irrigation
(home, irrigation, municipal, industrial)

WELL COMPLETION DATA:

- (1) diameter (inches) 18"
- (2) total depth (feet) 88'
- (3) static water level (feet) 23 below top of ground.
- (4) casing Steel 60' (material) (depth)
18" (size) if telescope see back.
- (5) screen 35 53' (length) (depth to top)
12" (size) St. Steel (material)
- (6) pump 40 1400 (HP) (yield gpm)
electric (type power)
- (7) electric log No (yes or no)
(organization running log)
- (8) how well bottom plugged St. Plate

DRILLERS REMARKS:

description of formations encountered	depth	
	from	to
Clay	0	14
Fine Sand	14	47
Med. Sand	47	50
Med.C. Sand & Pea Gravel	50	62
C.Sand & Gravel	62	88
Clay	88	92


CODED

RECEIVED

MAR 14 1978

If well telescopes please sketch and show depths.

GROUND LEVEL

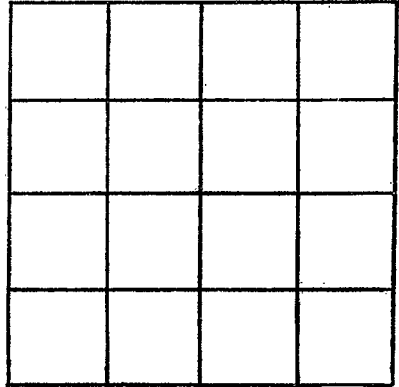

SECTION _____

Please indicate well location X.

ADDITIONAL INFORMATION

If more than one screen, show locations of each on sketch.