

WASH.  
 H72  
 8/30/77

MISSISSIPPI  
 BOARD OF WATER COMMISSIONERS  
 416 North State Street  
 Jackson, Mississippi 39201

CODED

WATER WELL DRILLERS LOG

8-30 19 78 Layne Central Co. Washington  
 date well completed firm name county well located

LANDOWNER: Potter Bros. Arcola, MS (mailing address)	description of formations encountered	from	to
	Clay	0	15
	Fine Sand	15	49
	Med. Coarse Sand	49	57
	Fine Sand	57	62
	Fine Sand	62	70
	Coarse Sand & Pea Gravel	70	82
	Gr. Sand & gravel	82	123
#2 WELL LOCATION: sec. <u>32</u> T <u>17</u> N R <u>7</u> W <u>4</u> miles W of Arcola (distance) (direction) (nearest town)			
WELL PURPOSE: Irrigation (home, irrigation, municipal, industrial)			
WELL COMPLETION DATA: (1) diameter (inches) <u>16"</u> (2) total depth (feet) <u>123'</u> (3) static water level (feet) <u>22'</u> below top of ground. (4) casing <u>Steel</u> <u>80'</u> (material) (depth) <u>16"</u> (size) If telescope see back. (5) screen <u>50'</u> <u>73'</u> (length) (depth to top) <u>12" &amp; 16" St. Steel</u> (size) (material) (6) pump <u>50</u> <u>2400</u> (HP) (yield gpm) <u>electric</u> (type power) (7) electric log <u>No</u> (yes or no) <u>(organization running log)</u> (8) how well bottom plugged <u>St. Plate</u>			
DRILLERS REMARKS:			


CODED

RECEIVED  
 MAR 14 1978

MISS. BD. OF WATER COMM.

If well telescopes please sketch and show depths.

GROUND LEVEL

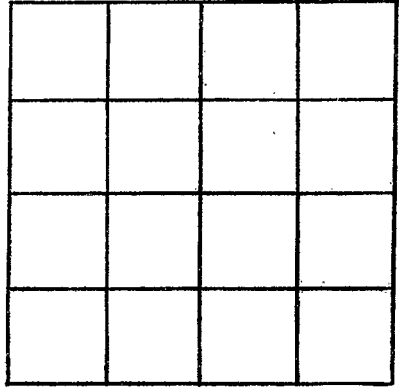

SECTION \_\_\_\_\_

Please indicate well location X.

ADDITIONAL INFORMATION

If more than one screen, show locations of each on sketch.