

DOW CHEMICAL JOB

WASHINGTON
H 73
11/15/78

MISSISSIPPI
BOARD OF WATER COMMISSIONERS
416 North State Street
Jackson, Mississippi 39201

WATER WELL DRILLERS LOG

CODEL

NOV. 15, 1978 date well completed
CHICOT IRRIGATION firm name
WASHINGTON county well located

LANDOWNER: DOW CHEMICAL
WAYSIDE, Miss.
(mailing address)

description of formations encountered	from	to
Top Soil & Clay	0	10
CLAY	10	20
SAND	20	60
GRAVEL	60	160
CLAY	160	300
FINE SAND & CLAY	300	400
COARSE SAND	400	440

WELL LOCATION:
sec. 10 T 17 N R 7 E
4 miles SOUTH of LELAND
(distance) (direction) (nearest town)

WELL PURPOSE:
(home, irrigation, municipal, industrial)

WELL COMPLETION DATA

- (1) diameter (inches) 4
- (2) total depth (feet) 440
- (3) static water level (feet) 25 below top of ground.
- (4) casing PVC 440 (material) (depth)
260 ft. 2" - 160 ft. 4" if telescope see back.
(size)
- (5) screen 20' 420' (length) (depth to top)
2" STAINLESS STEEL (size) (material)
- (6) pump 1 1/2 25 (HP) (yield gpm)
ELECTRICAL 220 Volts (type power)
- (7) electric log (yes or no)

(organization running log)

(8) how well bottom plugged PVC Cap

DRILLERS REMARKS:


LAKE VILLAGE, MISSISSIPPI
CHICOT IRRIGATION, INC.

RECEIVED
DEC 27 1978

MISS. BD. OF WATER COMMISSIONERS

If well telescopes please sketch and show depths.

GROUND LEVEL

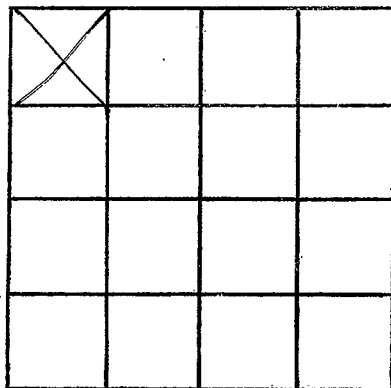

SECTION 10

Please indicate well location X.

ADDITIONAL INFORMATION

If more than one screen, show locations of each on sketch.