

Washington
H-74
4-23-80

MISSISSIPPI DEPARTMENT OF NATURAL RESOURCES
Bureau of Land and Water Resources
Southport Mall
P.O. Box 10631
Jackson, Mississippi 39209
WATER WELL DRILLERS LOG

CODED

Washington
~~Itomkeys~~

4-23-80 19 date well completed
Larry's Well & Pump firm name
Washington county well located

LANDOWNER: Billy Ray Handy
ARCOLA, MS.
(mailing address)

description of formations encountered	from	to
clay	0'	20'
fine sand	20'	37'
med sand	37'	45'
coarse sand	45'	75'
coarse sand & sng gravel	75'	112'

WELL LOCATION:
sec. 35 T. 17N S R. 7 E
1/2 miles W of ARCOLA
(distance) (direction) (nearest town)

WELL PURPOSE: fish ponds
(home, irrigation, municipal, industrial)

- WELL COMPLETION DATA:
- (1) diameter (inches) 16"
 - (2) total depth (feet) 112'
 - (3) static water level (feet) 20' ^{below} above top of ground.
 - (4) casing steel, 72'
(material) (depth)
(size) if telescope see back.
 - (5) screen 40, 72'
(length) (depth to top)
16", steel
(size) (material)
 - (6) pump 60 3000
(HP) (yield gpm)
diesel
(type power)
 - (7) electric log No
(yes or no)
(organization running log)
 - (8) how well bottom plugged steel plate

CODED


DEPT. OF NATURAL RESOURCES
BUREAU OF LAND & WATER RESOURCES

JUN 30 1980
RECEIVED

DRILLERS REMARKS:

If well telescopes please sketch and show depths.

GROUND LEVEL

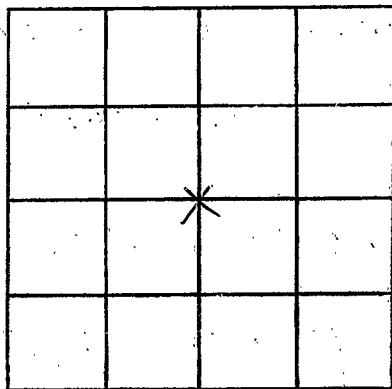

SECTION 35

Please indicate well location X.

ADDITIONAL INFORMATION

If more than one screen,
show locations of each on sketch.