

Washington
 H-75
 5/5/80
 S-5-

MISSISSIPPI DEPARTMENT OF NATURAL RESOURCES
 Bureau of Land and Water Resources
 Southport Mall
 P.O. Box 10631
 Jackson, Mississippi 39209
 WATER WELL DRILLERS LOG

CODED

1980 date well completed Harry's Well & Pump firm name Washington county well located

LANDOWNER: Harry Brayton
Heland, MS
 (mailing address)

description of formations encountered	from	to
clay	0'	22'
fine sand	22'	35'
med sand	35'	45'
coarse sand	45'	70'
coarse sand & s&g	70'	114'

WELL LOCATION:
 sec. 12-17N R. 7E
4 miles S of Heland
 (distance) (direction) (nearest town)

WELL PURPOSE: irrigation
 (home, irrigation, municipal, industrial)

- WELL COMPLETION DATA:
- (1) diameter (inches) 16"
 - (2) total depth (feet) 114'
 - (3) static water level (feet) 24' below top of ground.
 - (4) casing steel, 74' (material) (depth)
 (size) if telescope see back.
 - (5) screen 40' 74' (length) (depth to top)
16" steel (size) (material)
 - (6) pump 60 3000 (HP) (yield gpm)
diesel (type power)
 - (7) electric log No (yes or no)
 (organization running log)


(8) how well bottom plugged steel plate

DRILLERS REMARKS:

DEPT. OF NATURAL RESOURCES
 BUREAU OF LAND & WATER RESOURCES
 RECEIVED
 JUL 28 1980

If well telescopes please sketch and show depths.

GROUND LEVEL

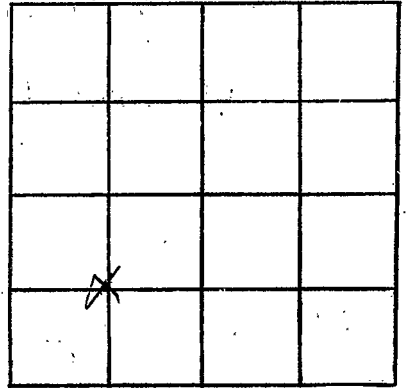

SECTION 12

Please indicate well location X.

ADDITIONAL INFORMATION

If more than one screen, show locations of each on sketch.