

WASHINGTON

CL-1306 4-76
7/31/79

MISSISSIPPI
BOARD OF WATER COMMISSIONERS CODED
416 North State Street
Jackson, Mississippi 39201

WATER WELL DRILLERS LOG

7-31-79 19 79 Layne-Central Co. Washington
date well completed firm name county well located

LANDOWNER:
Aqua Farms
Arcola, MS
(mailing address)

description of formations encountered	from	to
Clay	0	8
Fine Sand	8	16
C.Sand & Pea Gravel	16	95
Blue Clay	95	115

WELL LOCATION:
sec. 28-T-17 N R 7 E
5 miles East of Wayside
(distance) (direction) (nearest town)

Rock	115	117
Clay	117	145
Sand	145	153
Clay	153	162
Sand	162	176

WELL PURPOSE: irrigation
(home, irrigation, municipal, industrial)

Clay	176	183
Sandy Clay	183	189
Clay	189	247

WELL COMPLETION DATA:
(1) diameter (inches) 4"
(2) total depth (feet) 522'
(3) static water level (feet) 22' below top of ground.
(4) casing Steel 491' 5"
(material) (depth)
4-3" if telescope see back.
(size)
(5) screen 30' 7" 491' 5"
(length) (depth to top)
3" St. Steel
(size) (material)
(6) pump 30 1500
(HP) (yield gpm)
Electric
(type power)
(7) electric log no
(yes or no)
(organization running log)

Sand	247	250
Clay	250	254
Sand	254	257
Clay	257	290
Sand	290	292
Clay	292	298
Sand	298	303
Clay	303	340
Sand	340	359
Clay	359	360
Sand	360	363
Soft clay with stk. of sand	363	473
Sand	473	522

(8) how well bottom plugged
backpressure valve
DRILLERS REMARKS:


DEPT. OF NATURAL RESOURCES
BUREAU OF LAND & WATER RESOURCES

AUG 21 1980

RECEIVED

If well telescopes please sketch and show depths.

GROUND LEVEL

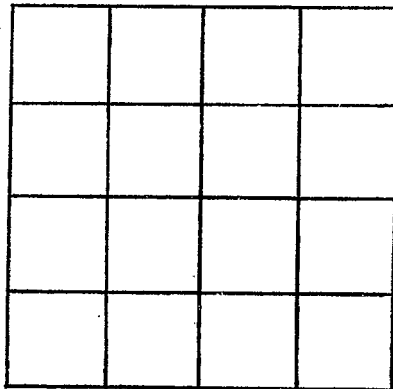

SECTION _____

Please indicate well location X.

ADDITIONAL INFORMATION

If more than one screen, show locations of each on sketch.