

MISSISSIPPI DEPARTMENT OF NATURAL RESOURCES

Bureau of Land and Water Resources

Southport Mall

P.O. Box 10631

Jackson, Mississippi 39209


WATER WELL DRILLERS LOG

CODED

Washington
H 82
12-22-80

12/22 1980 date well completed Larry's well & pump firm name Washington county well located

LANDOWNER:	description of formations encountered	from	to
Harry Branton Isola Plantation Leland MS (mailing address)	CLAY	0	35
	FINE SAND	35	50
	MED SAND	50	60
	COURSE SAND & GRAVEL	60	116
WELL LOCATION: sec. 14 T 17 N R 7 E 6 miles 5 of Leland (distance) (direction) (nearest town)			
WELL PURPOSE: (home, irrigation, municipal, industrial)			
WELL COMPLETION DATA:			
(1) diameter (inches) 16"			
(2) total depth (feet) 116'			
(3) static water level (feet) 24' below above top of ground.			
(4) casing Steel, 76' (material) (depth)			
(size) If telescope see back.			
(5) screen 40' 76' (length) (depth to top)			
16" steel (size) (material)			
(6) pump 40 (HP) (yield gpm)			
(type power)			
(7) electric log No (yes or no)			
(organization running log)			
(8) how well bottom plugged Steel Plate			

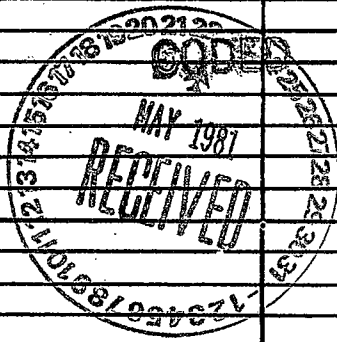

DRILLERS REMARKS:

If well telescopes please sketch and show depths.

GROUND LEVEL

X			

SECTION 14

Please indicate well location X.

ADDITIONAL INFORMATION

If more than one screen,
show locations of each on sketch.