

Washington
H85
1-17-80

MISSISSIPPI
BOARD OF WATER COMMISSIONERS
416 North State Street
Jackson, Mississippi 39201

WATER WELL DRILLERS LOG

4/17 1980 date well completed Dyer firm name Wash. county well located

LANDOWNER:
SANDY INGRAM
Leland, MS.
(mailing address)

description of formations encountered	CODED	from	to
Clay		0	2'
First sand		28	38
sand		38	45
sand & gravel		45	108


WELL LOCATION:
sec. 4 T-17N R-7E
5 miles S of Leland
(distance) (direction) (nearest town)

WELL PURPOSE:
(home/irrigation, municipal, industrial)

- WELL COMPLETION DATA:
- (1) diameter (inches) 16
 - (2) total depth (feet) 108'
 - (3) static water level (feet) 22' below top of ground.
 - (4) casing Steel 108
(material) (depth)
16" if telescope see back.
(size)
 - (5) screen 40' 68'
(length) (depth to top)
16" steel
(size) (material)
 - (6) pump 80 900
(HP) (yield gpm)
Diabel
(type power)
 - (7) electric log _____
(yes or no)


(organization running log)
 - (8) how well bottom plugged plate

DRILLERS REMARKS:

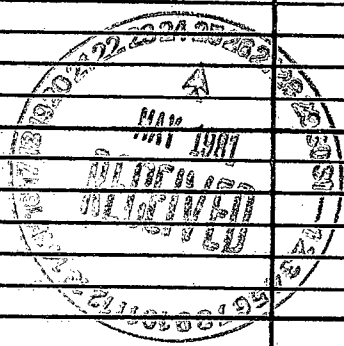

If well telescopes please sketch and show depths.

GROUND LEVEL

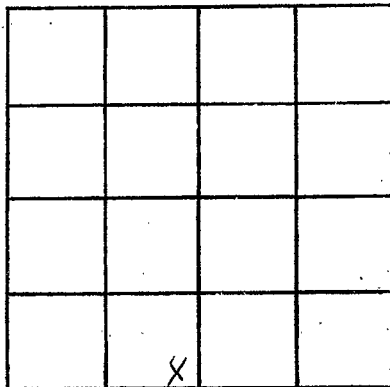

SECTION 4

Please indicate well location X:

ADDITIONAL INFORMATION

If more than one screen, show locations of each on sketch.