

MISSISSIPPI DEPARTMENT OF NATURAL RESOURCES

Bureau of Land and Water Resources

Southport Mall

P.O. Box 10631

Jackson, Mississippi 39209

WATER WELL DRILLERS LOG

CODED

WASHINGTON
H 87
7-17-81

7-17-81 date well completed Dyer Well Dring. firm name Washington county well located

LANDOWNER: Leo Wilkins
Hollandale, MS.

description of formations encountered	from	to
hard	15	23
hard	23	33
hard	33	43
hard	43	53
hard	53	63
hard	63	73
hard	73	83
hard	83	85

(mailing address)

WELL LOCATION:

sec. 16 T. 17 N. R. 2 E. S. 5 W. Leland
6 miles (distance) S of (direction) (nearest town)

WELL PURPOSE: (home, irrigation, municipal, industrial)


WELL COMPLETION DATA:

- (1) diameter (inches) 16"
- (2) total depth (feet) 85
- (3) static water level (feet) 22' below top of ground.
- (4) casing Steel (material), 45' (depth)
- 16" (size) If telescope see back.
- (5) screen 40' (length), 45' (depth to top)
- 16" (size), Steel (material)
- (6) pump 60 (HP), 3000 (yield gpm)
- electric (type power)
- (7) electric log no (yes or no)

(organization running log)


(8) how well bottom plugged plate

DRILLERS REMARKS:

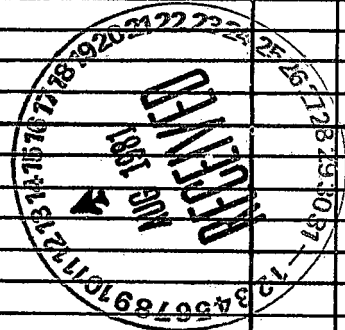

If well telescopes please sketch and show depths.

GROUND LEVEL

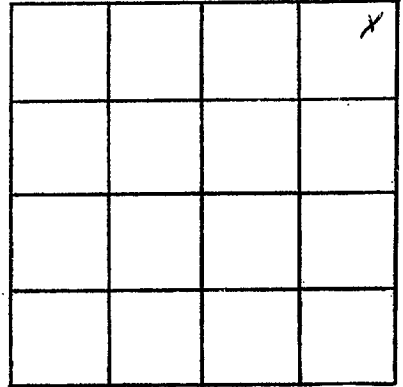

SECTION 16

Please indicate well location X.

ADDITIONAL INFORMATION

If more than one screen,
show locations of each on sketch.