

MISSISSIPPI DEPARTMENT OF NATURAL RESOURCES

Bureau of Land and Water Resources

Southport Mall

P.O. Box 10631

Jackson, Mississippi 39209

WATER WELL DRILLERS LOG

CODED

Washington  
H 890  
 CL-1891  
5-21-81

5-21-522-1981  
 date well completed

Layne-Central Company  
 firm name

Washington  
 county well located


LANDOWNER:	description of formations encountered	from	to
Allen Spragins			
Ieland, MS	Clay	14	20
(mailing address)	Med. Coarse sand	20	32
WELL LOCATION:	Coarse sand	32	42
sec. <u>8</u> T <u>19</u> N R <u>2</u> E	Med. sand	42	52
<u>5</u> miles <u>S-W</u> of <u>LELAND</u>	Coarse sand & Gravel	52	62
(distance) (direction) (nearest town)	Coarse sand & Gravel	62	72
WELL PURPOSE: <u>Irrigation</u>	Clay	72	74
(home, irrigation, municipal, industrial)			
WELL COMPLETION DATA:			
(1) diameter (inches) <u>28"</u>			
(2) total depth (feet) <u>73'7"</u>			
(3) static water level (feet) <u>21'</u> below top of ground.			
(4) casing <u>Steel</u> ( <u>53'7"</u> ) (material) (depth)			
<u>12"</u> (size) if telescope see back.			
(5) screen <u>20'</u> ( <u>53'7"</u> ) (length) (depth to top)			
<u>12"</u> (size) <u>St. steel</u> (material)			
(6) pump <u>20</u> ( <u>1000</u> ) (HP) (yield gpm)			
<u>DEL</u> (type power)			
(7) electric log <u>no</u> (yes or no)			
(organization running log)			
(8) how well bottom plugged <u>steel plate</u>			
DRILLERS REMARKS:			

CODED

DEPT. OF NATURAL RESOURCES  
 BUREAU OF LAND & WATER RESOURCES  
 OCT 20 1981  
 RECEIVED

If well telescopes please sketch and show depths.

GROUND LEVEL

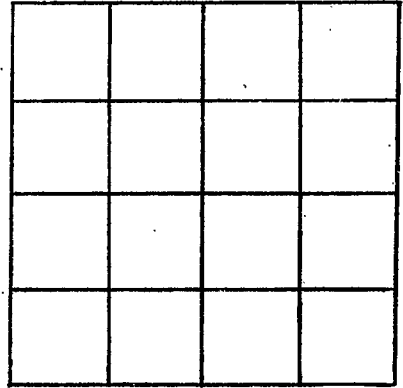

SECTION \_\_\_\_\_

Please indicate well location X.

ADDITIONAL INFORMATION

If more than one screen, show locations of each on sketch.