

MISSISSIPPI DEPARTMENT OF NATURAL RESOURCES

Bureau of Land and Water Resources

Southport Mall

P.O. Box 10631

Jackson, Mississippi 39209

WATER WELL DRILLERS LOG

WASHINGTON
H 95
3/30/83
3-30-83

date well completed

firm name

county well located

Schultz Drilling Washington

LANDOWNER:

AQUA FARMS

Wilmont Rd. Greenville

(mailing address)

WELL LOCATION:

sec. 29 T. 17 N. R. 6 E. S. 6
4 miles NE of Arcola
(distance) (direction) (nearest town)

WELL PURPOSE:

(home, irrigation, municipal, industrial)

WELL COMPLETION DATA:

- (1) diameter (inches) 10"
- (2) total depth (feet) 90'
- (3) static water level (feet) 35' below above top of ground.
- (4) casing PVC, 50' (material) (depth)
- (size) If telescope see back.
- (5) screen 40' 50' (length) (depth to top)
10" PVC (size) (material)
- (6) pump 20 900 (HP) (yield gpm)
ele (type power)
- (7) electric log NO (yes or no)
X (organization running log)
- (8) how well bottom plugged CAP

description of formations encountered

from

to

CLAY	0	30
SAND	30	45
COARSE SAND	45	65
COARSE SAND, pea GRAVEL	65	91

CODED


DRILLERS REMARKS:

DEPT. OF NATURAL RESOURCES
BUREAU OF LAND & WATER RESOURCES

APR 20 1983
RECEIVED

If well telescopes please sketch and show depths.

GROUND LEVEL

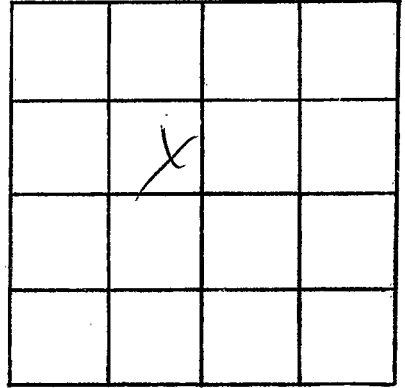

SECTION 29

Please indicate well location X.

ADDITIONAL INFORMATION

If more than one screen, show locations of each on sketch.