

WASHINGTON
H 96
6/6/83

MISSISSIPPI DEPARTMENT OF NATURAL RESOURCES
Bureau of Land and Water Resources
Southport Mall
P.O. Box 10631
Jackson, Mississippi 39209
WATER WELL DRILLERS LOG

CODED

6-6 1983 Schultz Drilling Washington
date well completed firm name county well located

LANDOWNER:	description of formations encountered	from	to
AQUA FARMS			
Greenville MS (mailing address)	CLAY MED. SAND COARSE SAND	0 42 60	42 66 80
WELL LOCATION: sec. 28 T-17 N R-7 E 6 miles SE of Greenville (distance) (direction) (nearest town)			
WELL PURPOSE: IRRIGATION (home, irrigation, municipal, industrial)			
WELL COMPLETION DATA:			
(1) diameter (inches) 10"			
(2) total depth (feet) 80'			
(3) static water level (feet) 23' below top of ground.			
(4) casing PVC 86' (material) (depth)			
(size) if telescope see back.			
(5) screen 20' 60' (length) (depth to top)			
10" PVC (size) (material)			
(6) pump 15 600 (HP) (yield gpm)			
ele (type power)			
(7) electric log NO (yes or no)			
(organization running log)			
(8) how well bottom plugged CAP			
DRILLERS REMARKS:			

CODED


DEPT. OF NATURAL RESOURCES
BUREAU OF LAND & WATER RESOURCES

JUN 23 1983

RECEIVED

If well telescopes please sketch and show depths.

GROUND LEVEL

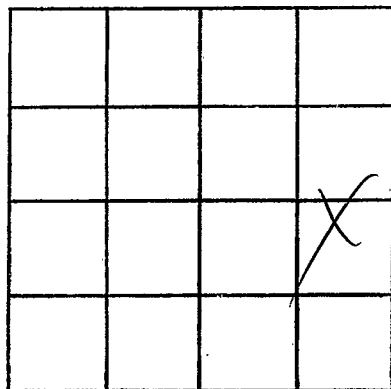

SECTION _____

Please indicate well location X.

ADDITIONAL INFORMATION

If more than one screen,
show locations of each on sketch.