

MISSISSIPPI DEPARTMENT OF NATURAL RESOURCES

Bureau of Land and Water Resources

Southport Mall

P.O. Box 10631

Jackson, Mississippi 39209

WATER WELL DRILLERS LOG

CODED

WASHINGTON
H 97
6/30/83

6-30 1983 Schultz Drilling Washington
date well completed firm name county well located

LANDOWNER: AQUA FARMS
Wilmont Rd.
Greenville MS
(mailing address)

| description of formations encountered | from | to |
|---------------------------------------|------|----|
| | CLAY | 0 |
| SAND | 30 | 60 |
| Coarse SAND | 60 | 92 |

WELL LOCATION:
sec. 28 T. 17 N. R. 7 E
6 miles SE of Greenville
(distance) (direction) (nearest town)

WELL PURPOSE: IRRIGATION
(home, irrigation, municipal, industrial)

CODED

- WELL COMPLETION DATA:
- (1) diameter (inches) 16"
 - (2) total depth (feet) 92'
 - (3) static water level (feet) 19' below above top of ground.
 - (4) casing PVC 62' (material) (depth)
 - (5) screen 40' 62' 52' (length) (depth to top)
 - (6) pump 16" 40 hp 1000 (size) (HP) (material) (yield gpm)
 - (7) electric log NO (yes or no)
 - (8) how well bottom plugged CAP. (organization running log)


DEPT. OF NATURAL RESOURCES
BUREAU OF LAND & WATER RESOURCES
JUL 6 1983

DRILLERS REMARKS:

RECEIVED

If well telescopes please sketch and show depths.

GROUND LEVEL

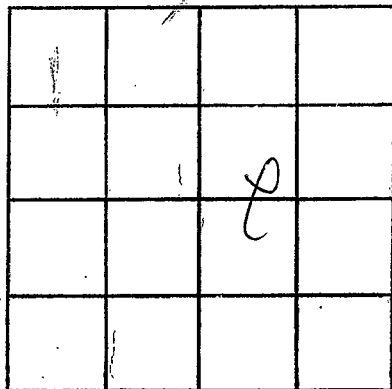

SECTION _____

Please indicate well location X.

ADDITIONAL INFORMATION

If more than one screen,
show locations of each on sketch.