

MISSISSIPPI DEPARTMENT OF NATURAL RESOURCES

Bureau of Land and Water Resources

Southport Mall

P.O. Box 10631

Jackson, Mississippi 39209

WATER WELL DRILLERS LOG

CODED

Washington
 *H 98
 5/19/82

5-19 1982 Schultz Drilling Washington
 date well completed firm name county well located

LANDOWNER: Aqua Farms
 Wilmont Rd
 Greenville Ms
 (mailing address)

description of formations encountered	from	to
clay	0	30
med to coarse sand	30	60
coarse sand	60	80

WELL LOCATION:
 sec 18 T 17 N S R 7 E W
 5 miles NW of Arcola
 (distance) (direction) (nearest town)

CODED

WELL PURPOSE:
 (home, irrigation, municipal, industrial)

WELL COMPLETION DATA:

(1) diameter (inches) 10"

(2) total depth (feet) 80'

(3) static water level (feet) 22 below top of ground.

(4) casing PVC 40' (material) (depth)

10" (size) if telescope see back.

(5) screen 40' (length) (depth to top)

10" PVC (size) (material)

(6) pump 15 (HP) 700 (yield gpm)

elec (type power)

(7) electric log no (yes or no)

(organization running log)

(8) how well bottom plugged PVC cap

DRILLERS REMARKS:


DEPT. OF NATURAL RESOURCES
 BUREAU OF LAND & WATER RESOURCES

JUN - 8 1982

RECEIVED

If well telescopes please sketch and show depths.

GROUND LEVEL

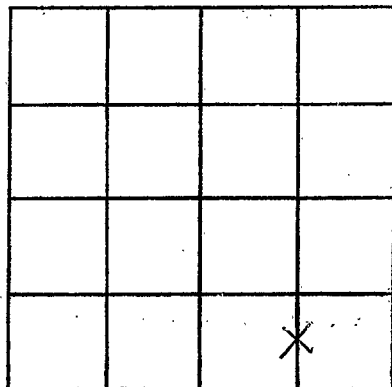

SECTION _____

Please indicate well location X.

ADDITIONAL INFORMATION

If more than one screen,
show locations of each on sketch.